


T.33S. R.9W. W.M.

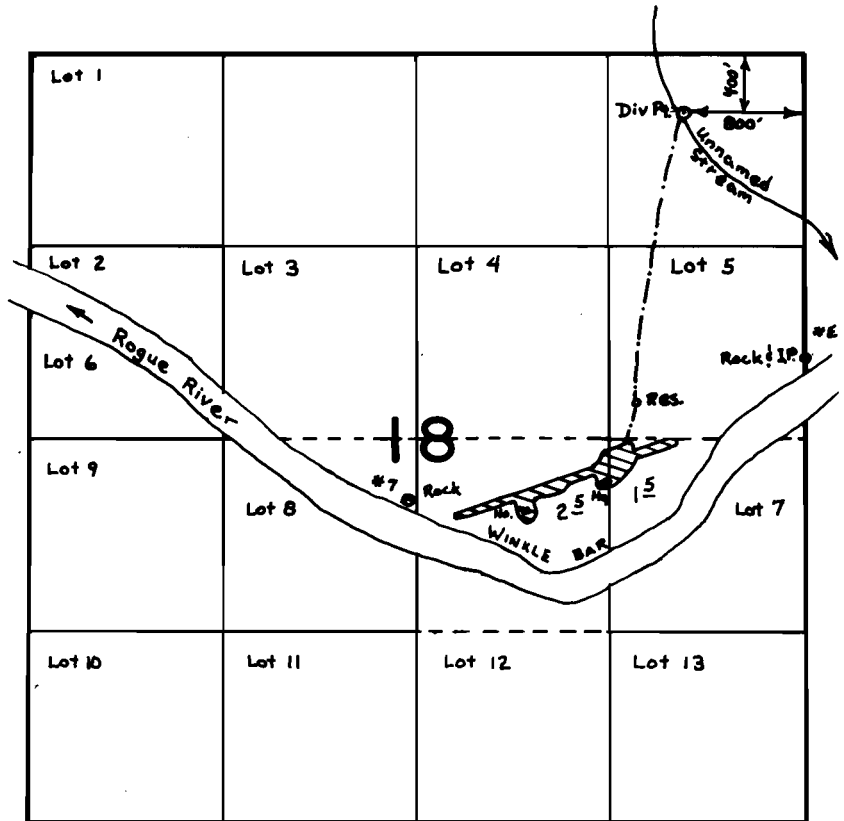

SCALE: 4" = 1 mile

FINAL PROOF SURVEY
UNDER

Application No. 40670 ~~Permit~~ No. 30310
IN NAME OF

WALTER A. HAAS, Jr.

Surveyed Aug. 29. 1978, by D. Sparks.....