


T. 35 S., R. 2 W., W.M.

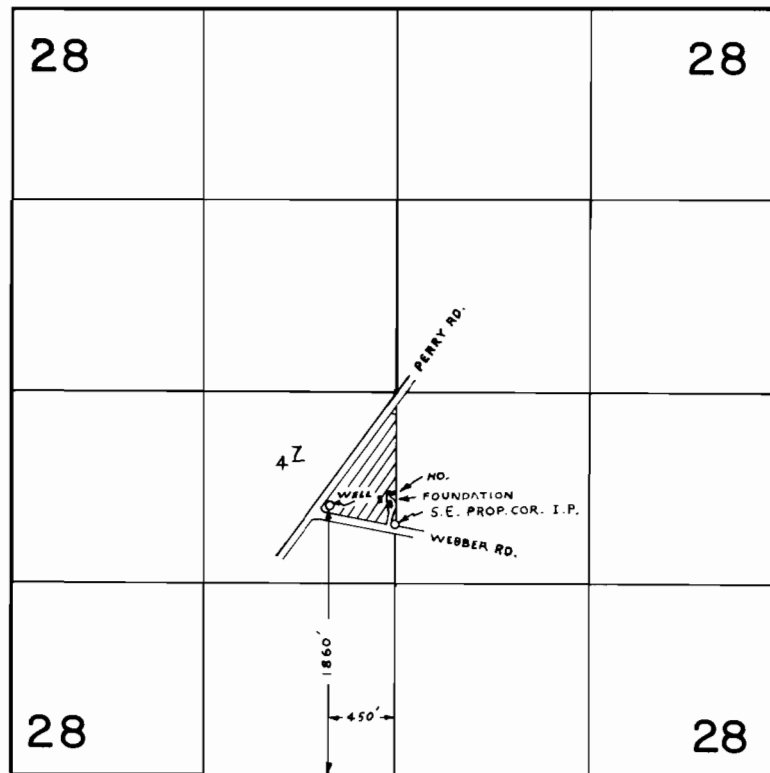

FINAL PROOF SURVEY
UNDER

Application No. G-6985 Permit No. G-6491
IN NAME OF

LEWIS E. &/OR MADGE V. SHAFFER

Surveyed APR. 12 1978, by B. SUND