


T.37 S., R.2 W., W.M.

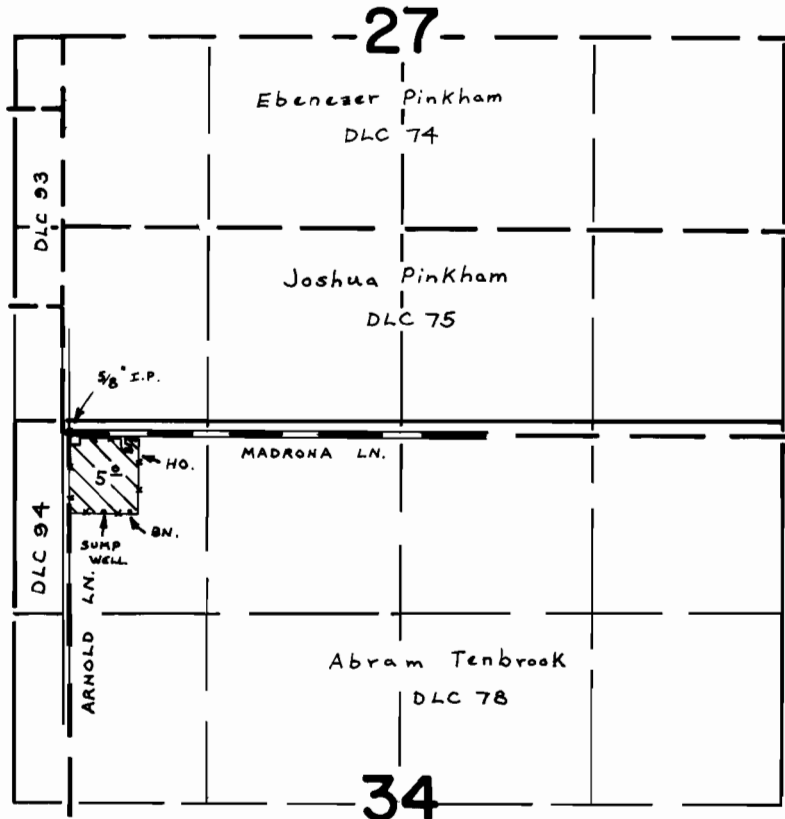

SUMP WELL LOC. - 540' S. & 240' E. FROM N.W. COR., TENBROOK DLC 78

**FINAL PROOF SURVEY
UNDER**

Application No. G-7024 Permit No. G-6517
IN NAME OF

CHARLES W. KLEINHANS

Surveyed OCT. 5 1978, by B. SUND

D.H.M.
P.T.S. - 1978-14-D