


# T. 35 S., R. 4 W., W.M.

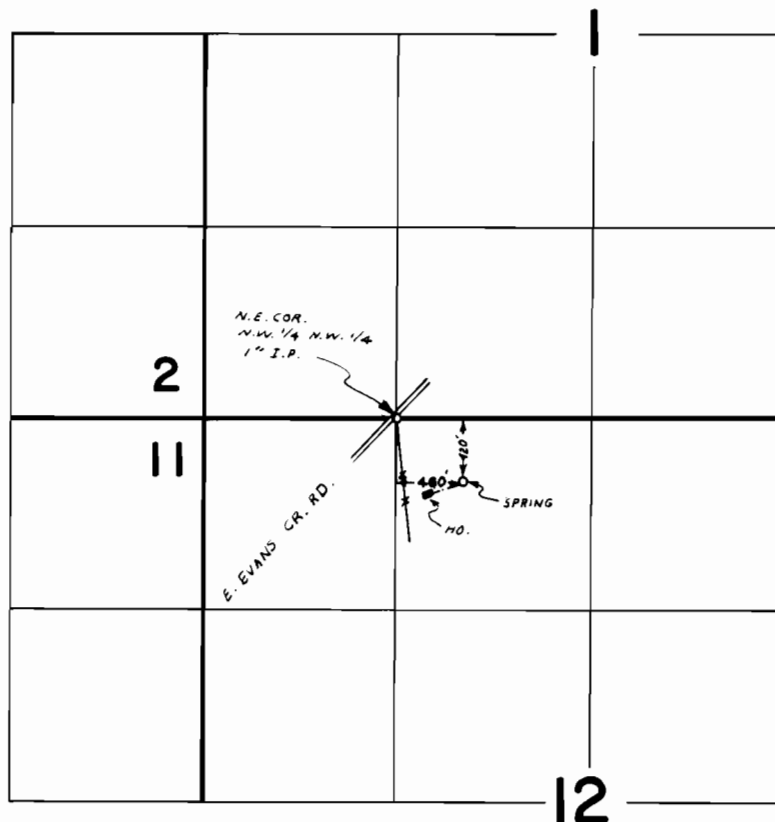

## FINAL PROOF SURVEY UNDER

Application No. 48536 Permit No. 36428  
IN NAME OF

J. D. ADAMSON

Surveyed NOV. 6 1978, by B. SUND