


# T. 40 S., R. 3 W., W.M.

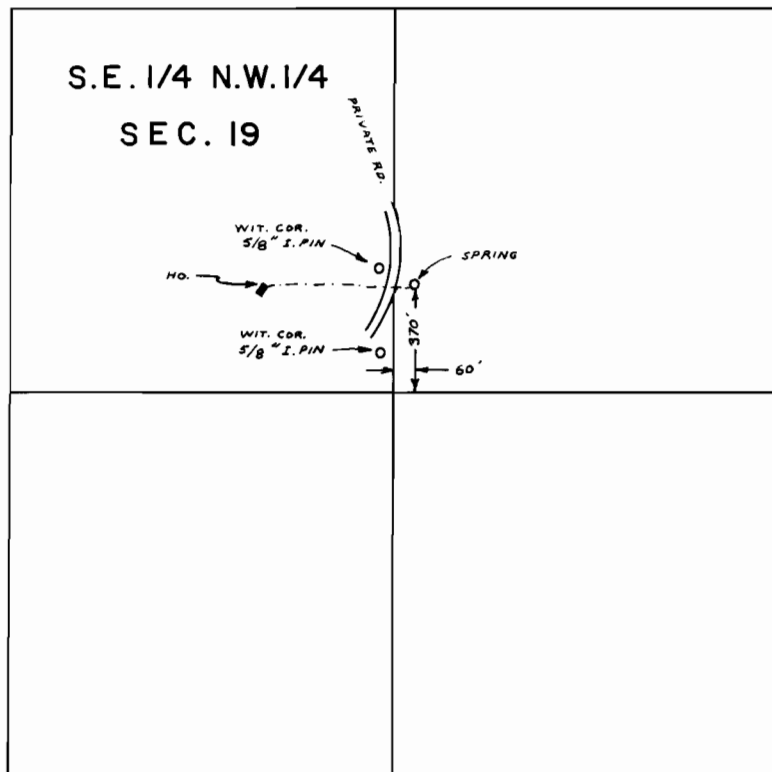

SCALE: 1" = 660 FT.

## FINAL PROOF SURVEY UNDER

Application No. 50482 Permit No. 38124

IN NAME OF

LARRY T. & MARY J. BYRNE

Surveyed NOV. 13 1978, by B. SUND