


T. 35 S., R. 3 W., W.M.

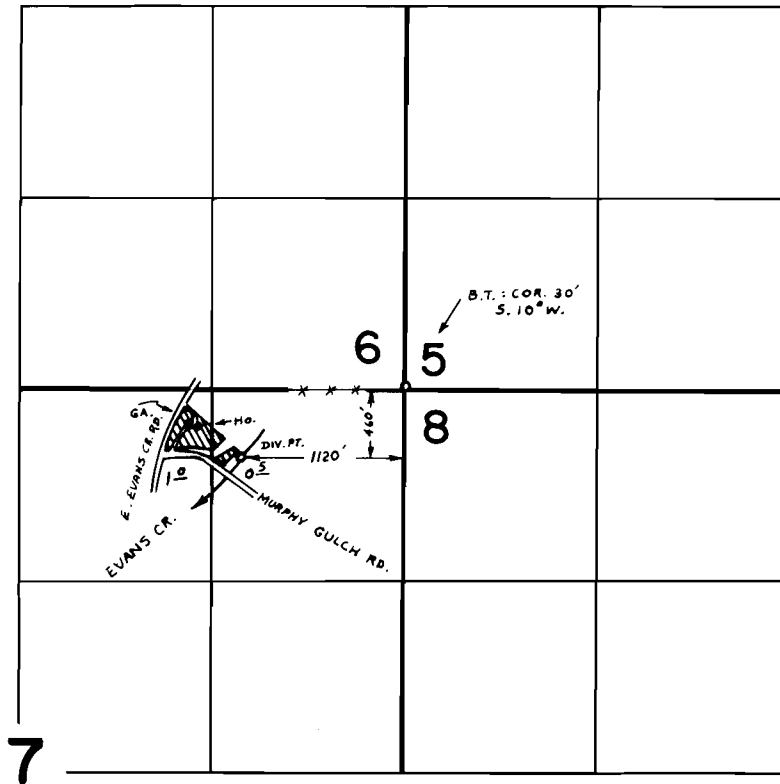

FINAL PROOF SURVEY UNDER

Application No. 53412 Permit No. 39749
IN NAME OF

M. A. WALTER

Surveyed MAY 18 1978, by B. SUND