


# T. 35 S., R. 4 W., W.M.

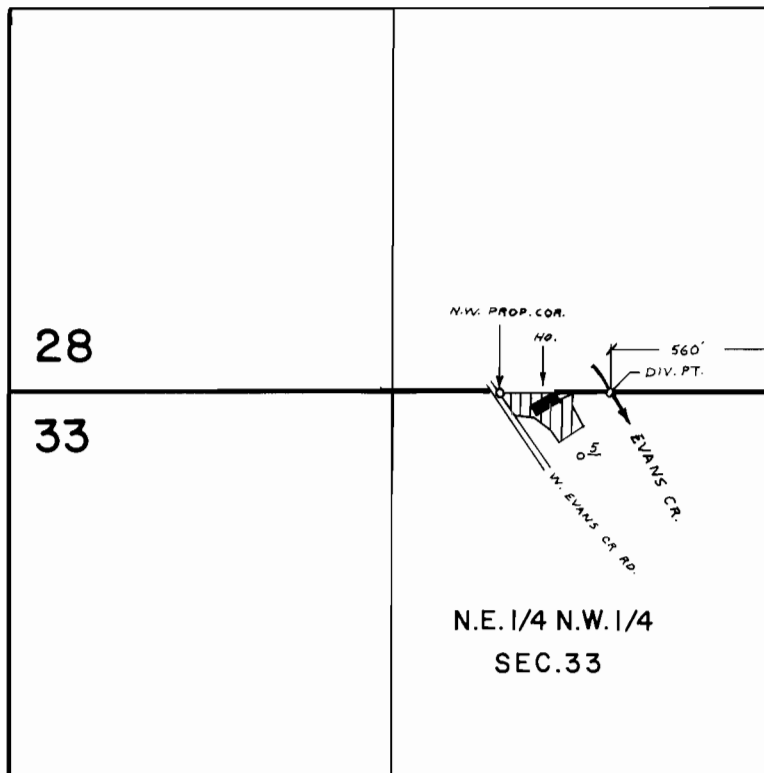

SCALE: 1" = 660 FT.

## FINAL PROOF SURVEY UNDER

Application No. 56015 Permit No. 42271  
IN NAME OF

GORDON THRONE

Surveyed AUG. 2 1978, by B. SUND