


# T.39&40S., R.7&8W., W.M.

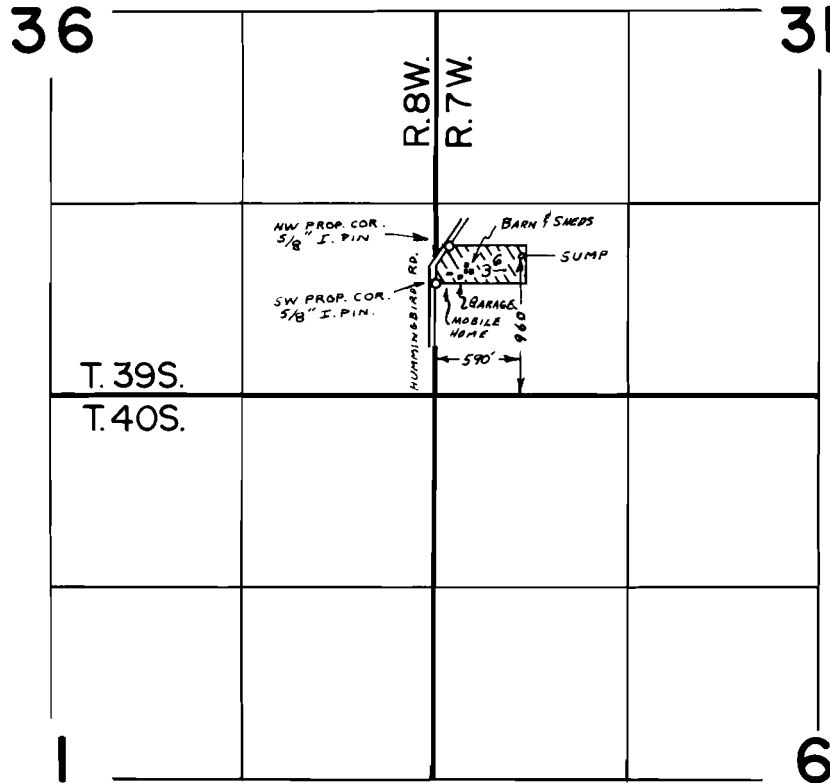

## FINAL PROOF SURVEY UNDER

Application No. G-5608 Permit No. G-5454

IN NAME OF

PHILIP L. PAQUIN

Surveyed AUG. 7 78 by B. SUND  
19....., by .....