


T. 38 S., R. 8 W., W.M.

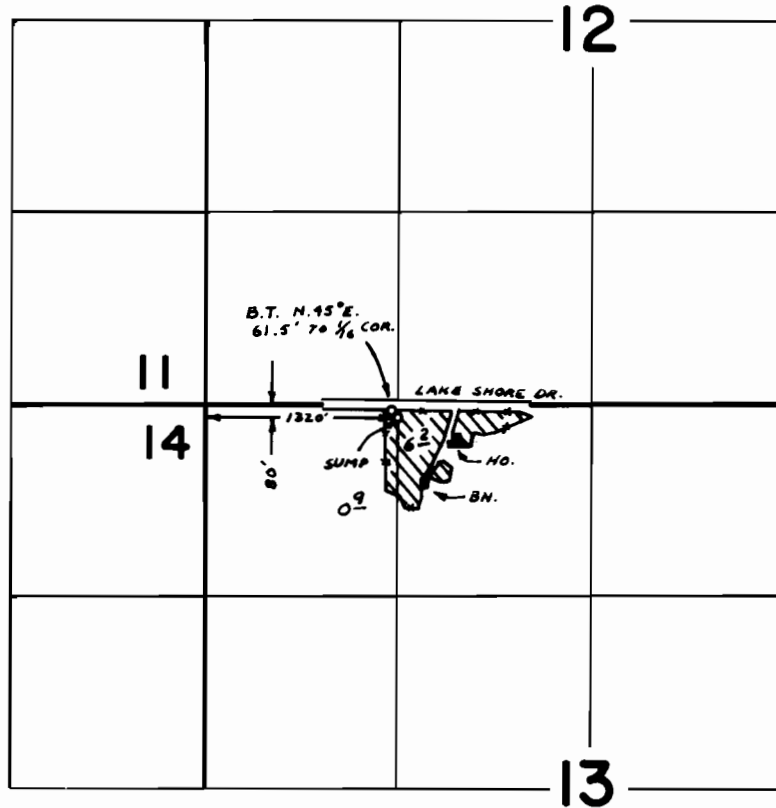

FINAL PROOF SURVEY
UNDER

Application No. G-6137 Permit No. G-5831
IN NAME OF

DON OLIPHANT

Surveyed JUL. 19 1978, by B. SUND