


RECEIVED
OCT 23 1971
STATE ENGINEER
SALEM OREGON

T.17S.R.3W.W.M.

RECEIVED
OCT 23 1971
STATE ENGINEER
SALEM OREGON

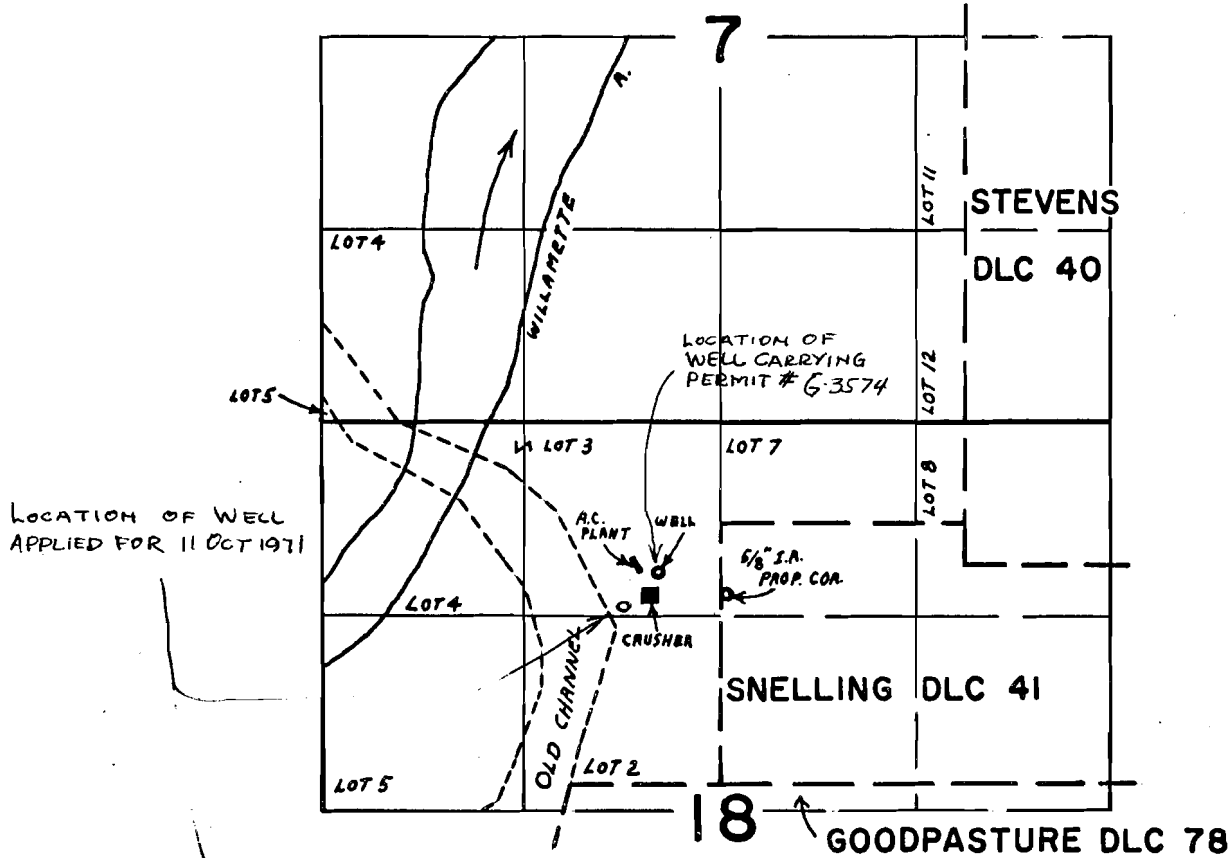

WELL LOC. 830' S. & 430' W. FROM NW COR. SNELLING DLC 41
WELL LOC. 570' S. & 595' W. FROM NW COR. SNELLING DLC 41

FINAL PROOF SURVEY

UNDER

Application No. G-3792 Permit No. G-3574

IN NAME OF

EUGENE SAND & GRAVEL, INC.

Surveyed OCT. 15, 1970, by G. BACA

Application No. G-5663
Permit No. G-5489