


T17S. R5W. WM.

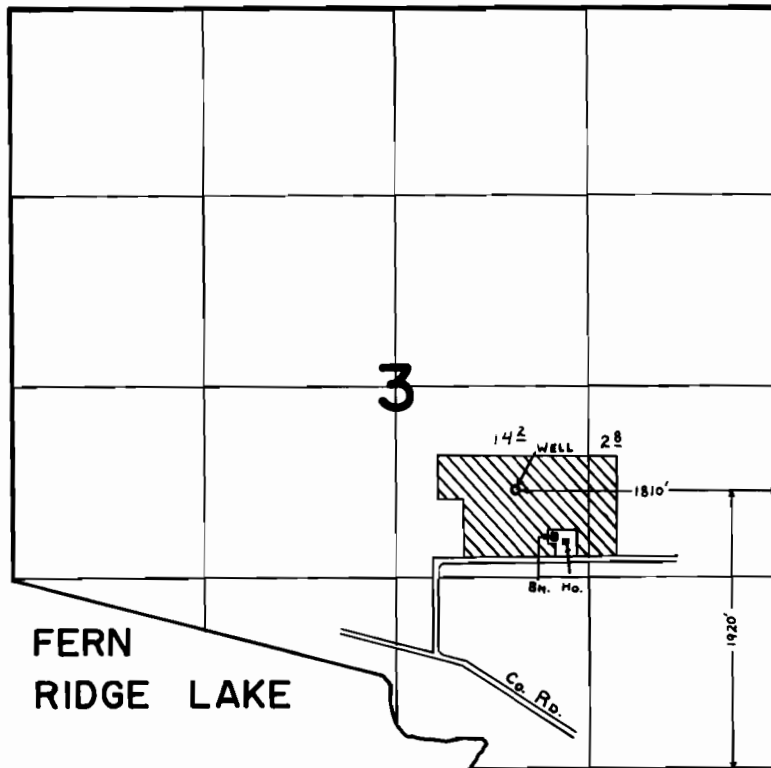

FINAL PROOF SURVEY
UNDER

Application No. G-7857 Permit No. G-7726
IN NAME OF

JOHN R. RATLIFF, JR.

Surveyed JUNE 12 1978, by C. L. HUGHES.