


T16S. R6W. WM.

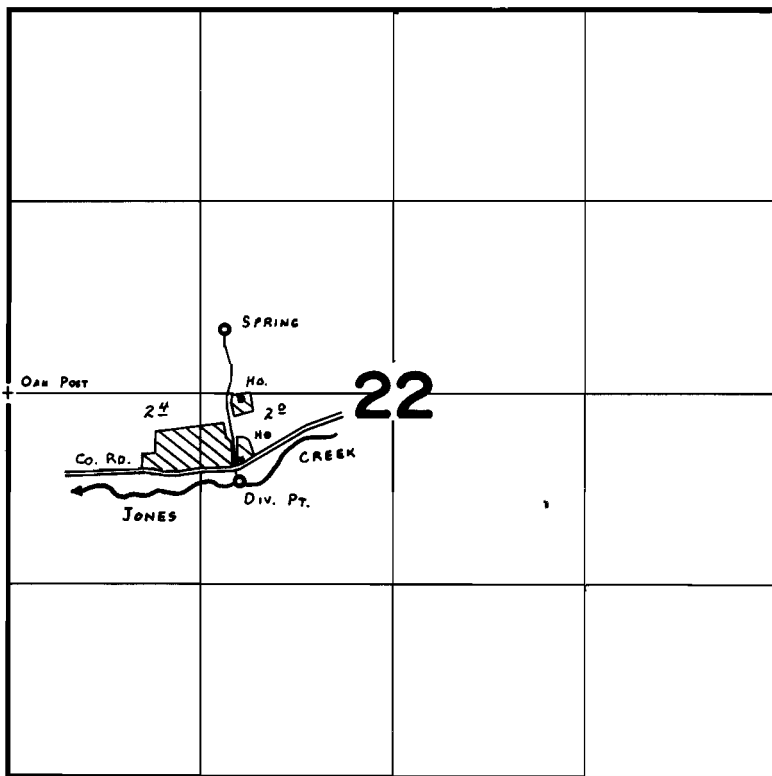

SPRING LOC: 440' N. & 1480' E. } BOTH fr. W. 1/4 COR. SEC. 22.
DIV. PT. LOC: 600' S. & 1590' E. }

FINAL PROOF SURVEY

UNDER

Application No. 49890 Permit No. 36708
IN NAME OF

WILLIAM L. & JOYCE M. MATTSON

Surveyed JUNE 13, 1978, by C. L. HUGHES