


# T18S. R2W. WM.

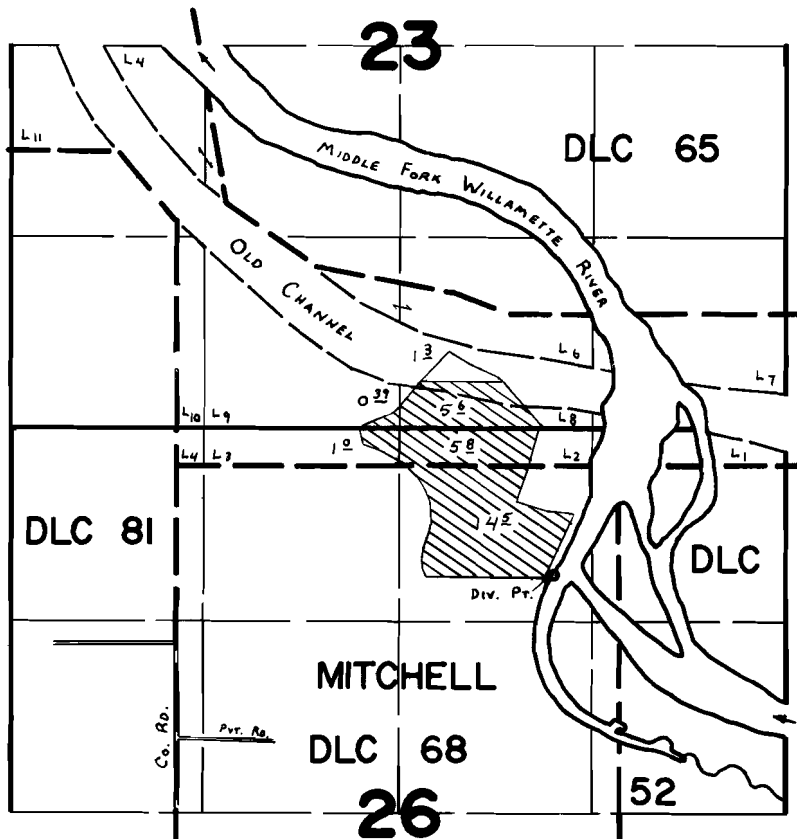

Div. Pt. Loc: 750'S. & 2600'E. fr. N.W. CoR. MITCHELL D.L.C. 68.

## FINAL PROOF SURVEY UNDER

Application No. 50128... Permit No. 36791...  
IN NAME OF

L. W. TENNIS

Surveyed MAY 23 1978, by C. L. HUGHES...