


RECEIVED

MAR 30 1977

LANDS DEPT.

T.18S.R.2W.W.M.

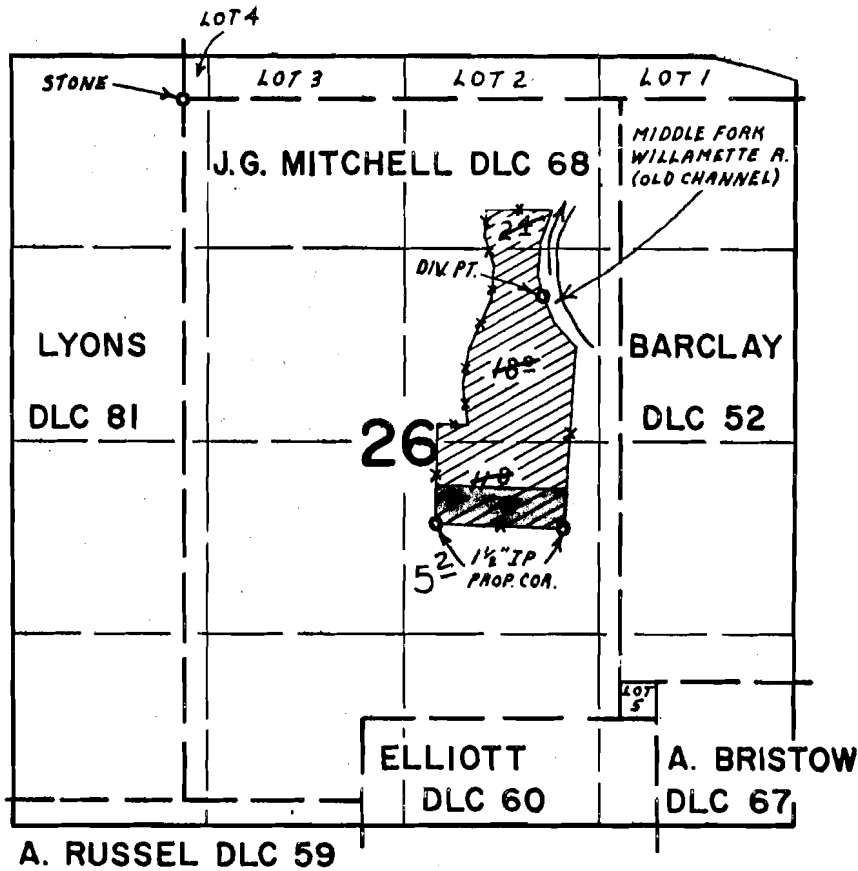

DIV. PT. LOC. 1340'S. & 2420'E. FROM N.W. COR. J.G. MITCHELL DLC 68

Application No. 55589

Permit No. 41658

FINAL PROOF SURVEY

UNDER

Application No. 44677 Permit No. 33119

IN NAME OF

L.W. TENNIS

Surveyed OCT. 12 19 72, by G. BACA