


T19S. R3W. WM.

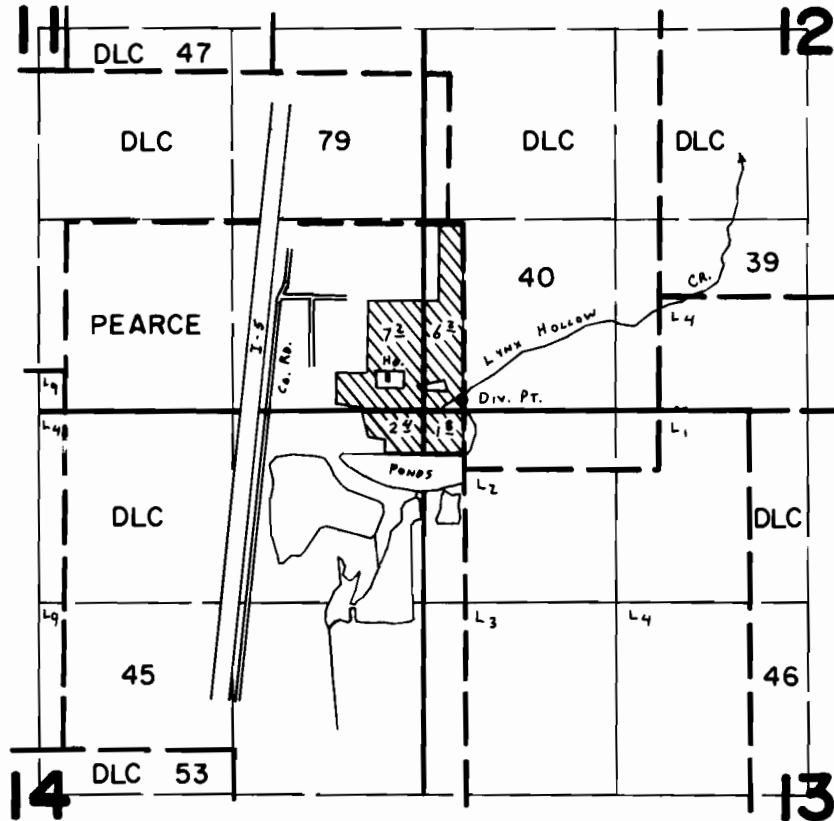

Div. Pt. Loc: 1210'S. E 10' W. fr. N.E. Cor. PEARCE DLC 45.

FINAL PROOF SURVEY UNDER

Application No. 49609 Permit No. 37220
IN NAME OF

MICHAEL J. PALANUK

Surveyed MAY 22 1978, by C. L. HUGHES