


T16S. R2W. WM.

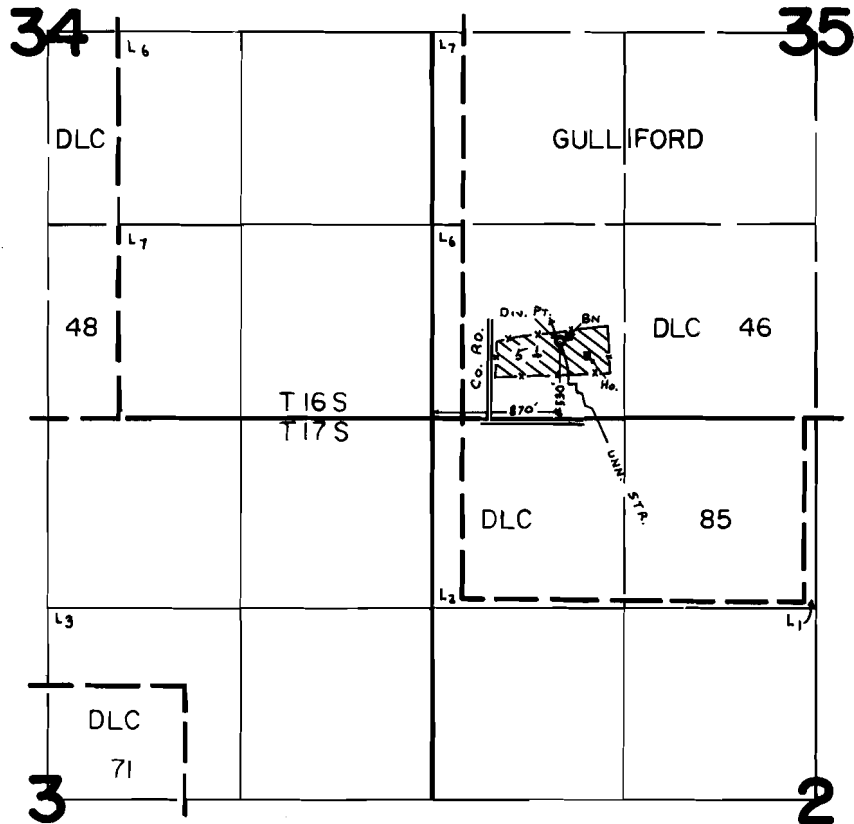

FINAL PROOF SURVEY
UNDER

Application No. 50532 Permit No. 37710
IN NAME OF

NORMAN K. & MARGARET J. VAN CLEAVE

Surveyed JULY 17, 1978, by C. L. HUGHES