

LANE COUNTY

1"=400'

See Map 19 01 21

RECEIVED
APR 19 1933
STATE ENGINEER
SALEM, OREGON

20 21
29 28
N 820,779
E 1,387,243


21 22
28 27
N 820,479
E 1,392,526

See Map 19 01, 29

See Map 19 01

29 28
32 33
N 815,433
E 1,386,970

28 27
33 34
N 815,258
E 1,392,328

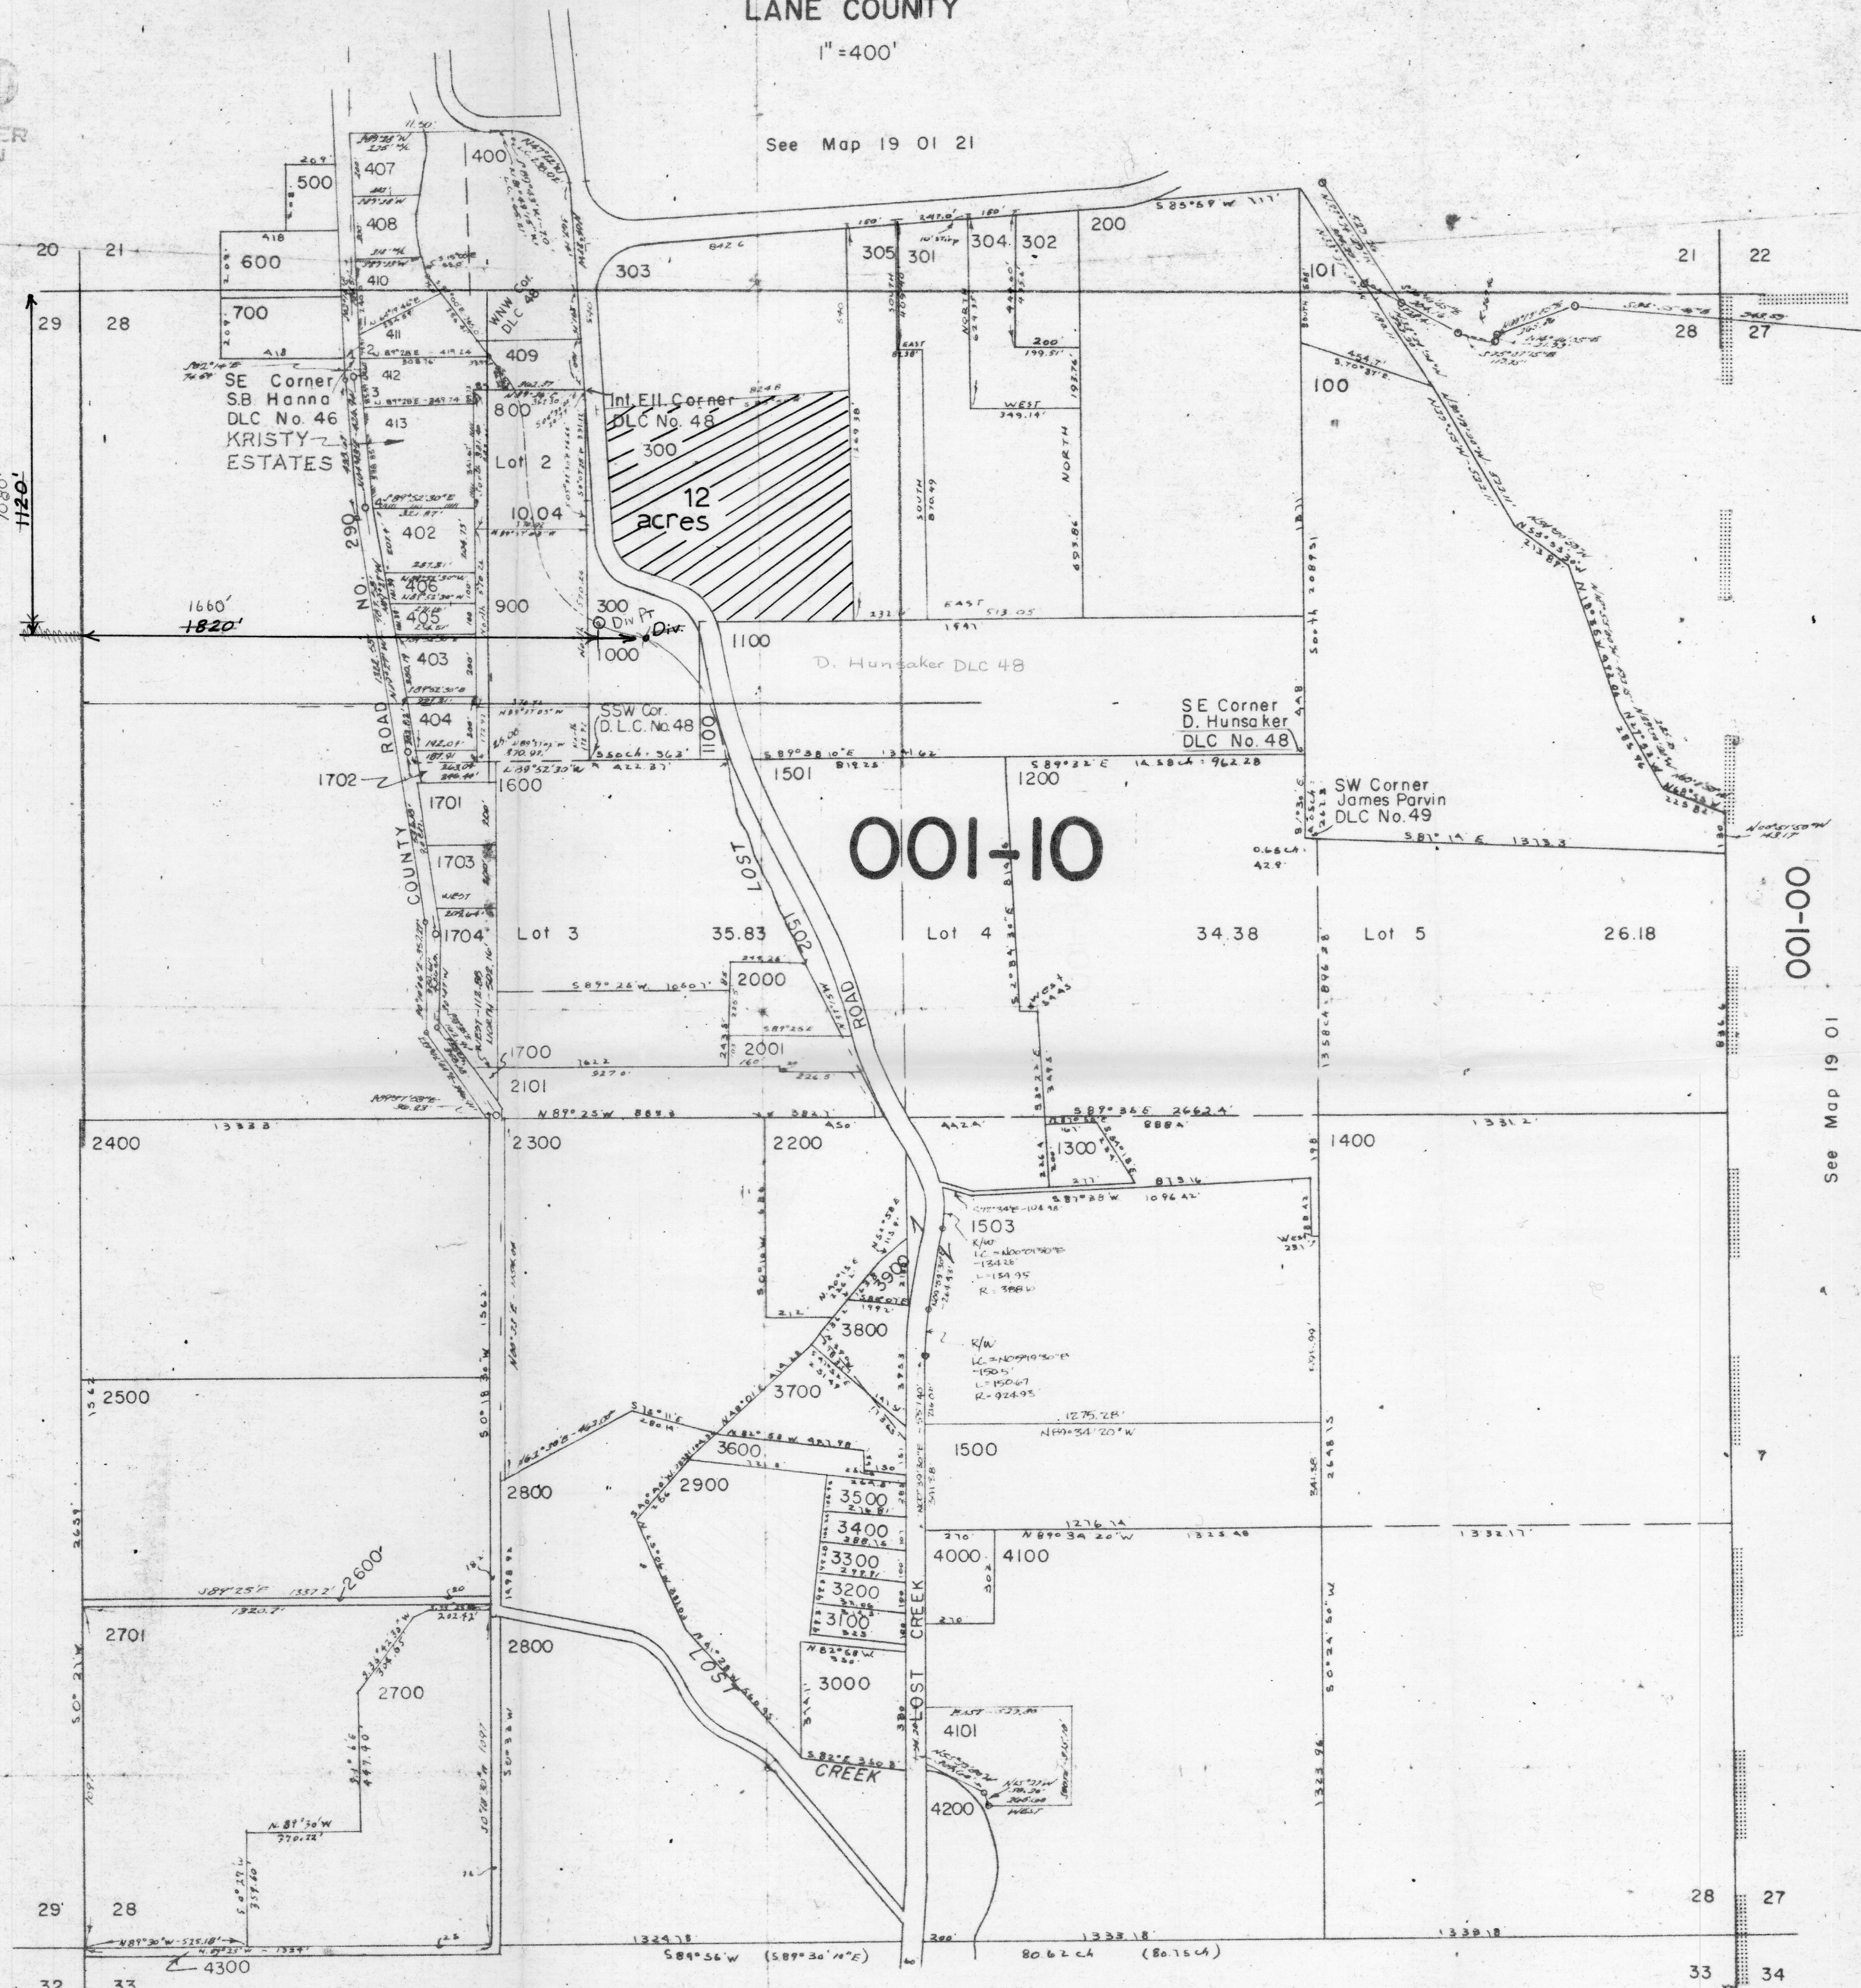

See Map 19 01 33

Application No.
Permit No.

30270
37890

3