


T19S. RIW. WM.

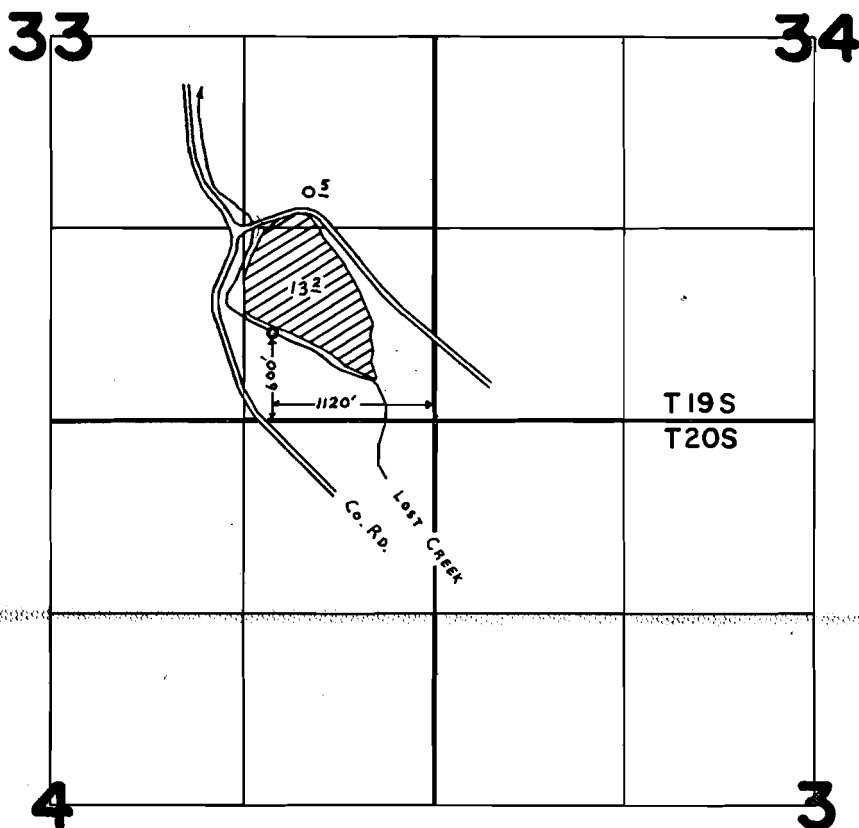

FINAL PROOF SURVEY
UNDER

Application No. 53650... Permit No. 38993...
IN NAME OF

WILLIAM JACOB BEALS, JR.

Surveyed JULY 19. 1978., by C. L. HUGHES...