T19S. R1W. WM.

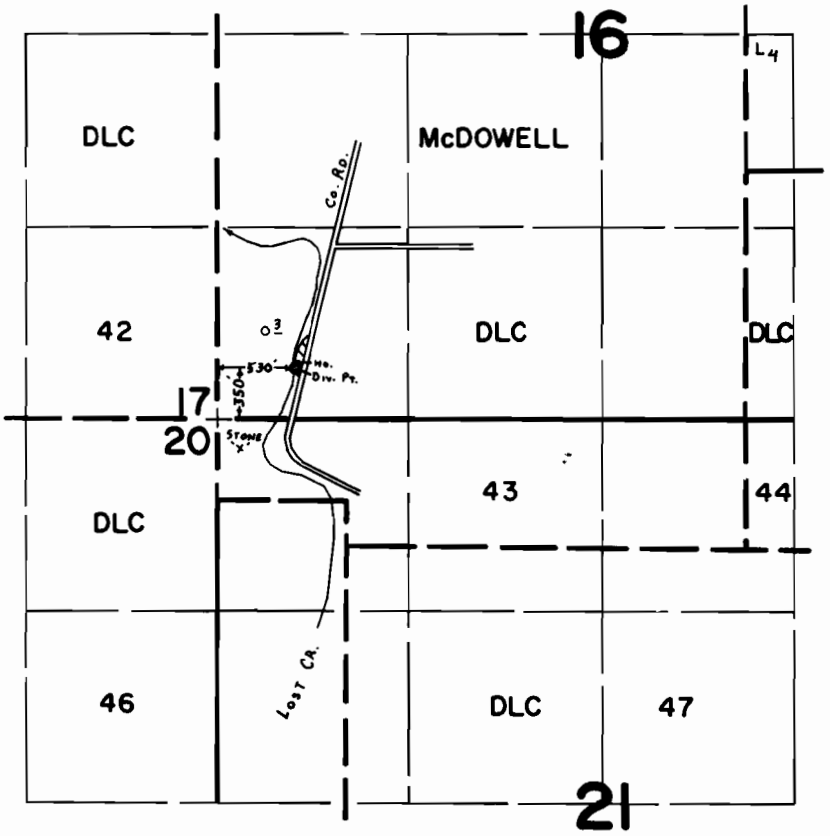

FINAL PROOF SURVEY
UNDER

Application No. 52192 Permit No. 39298
IN NAME OF

JAMES T. & SUSAN D. OGLE

Surveyed JULY 19 1978, by C. L. HUGHES

DBQ-433-96