


T17S. RIW. WM.

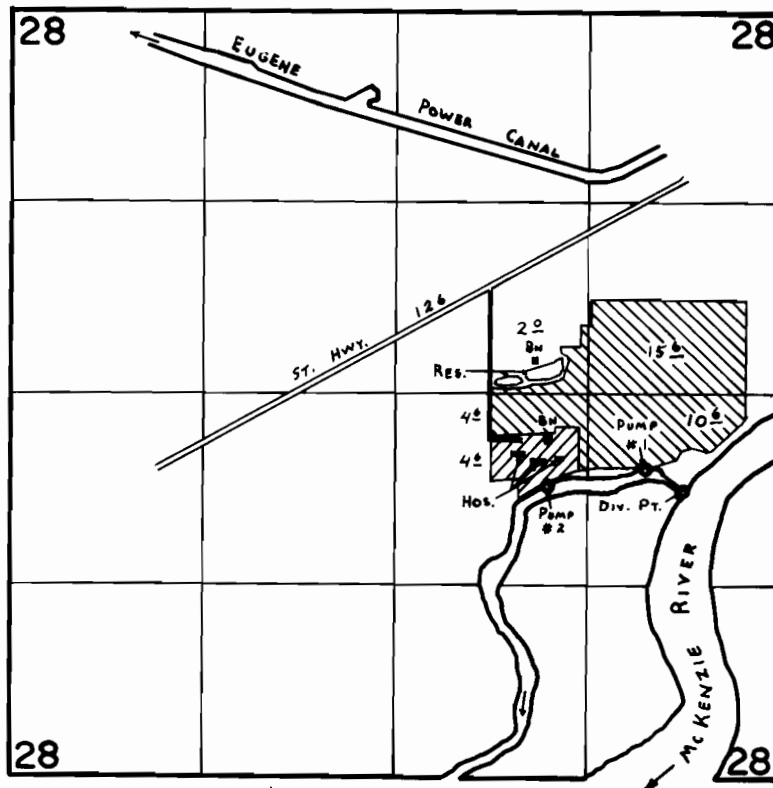

DIV. PT. Loc: 3280'S. & 660'W.
 PUMP #1 Loc: 3130'S. & 920'W.
 PUMP #2 Loc: 3250'S. & 1890'W. } ALL FROM N.E. COR. SEC. 28.
 ▨ - IRR. BY PUMP #1.
 ▩ - IRR. BY PUMP #2.

FINAL PROOF SURVEY UNDER

Application No. 52504 Permit No. 39632
 IN NAME OF

CARL L. WILSON

Surveyed JULY 18 1978, by C. L. HUGHES