


T17S. R2W. WM.

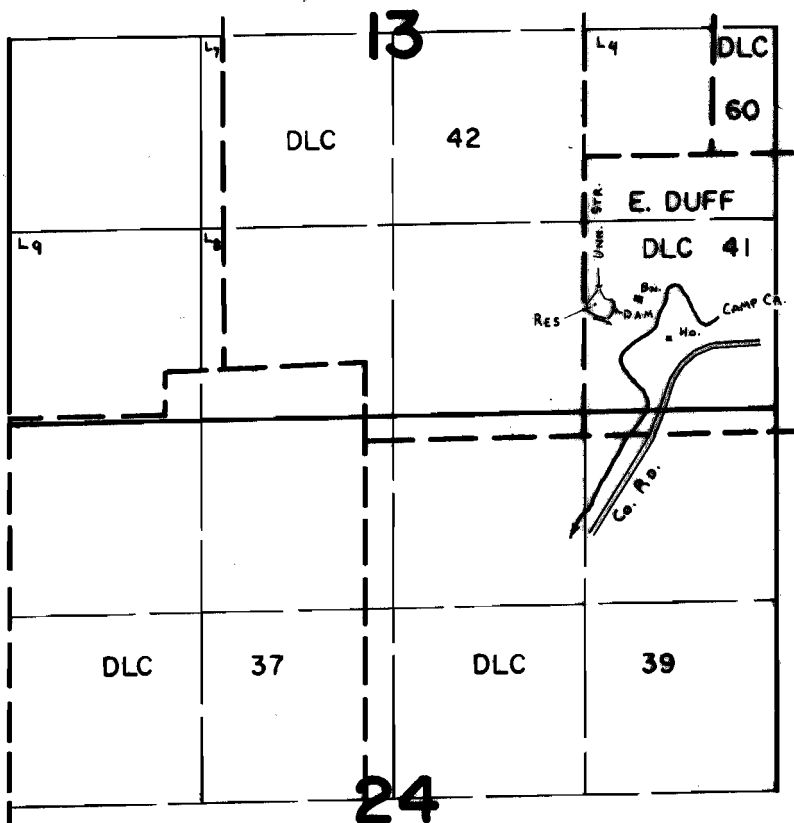

DAM Loc: 850' N. & 200' E. fr. S.W. Cor. E. DUFF DLC 41.

FINAL PROOF SURVEY UNDER

Application No. 53652 Permit No. 40334
~~R-53651~~ ~~R-6429~~
 IN NAME OF

CHARLES L. WRIGHT

Surveyed JULY 17 1978, by C. L. HUGHES