


T18S. R11W. WM.

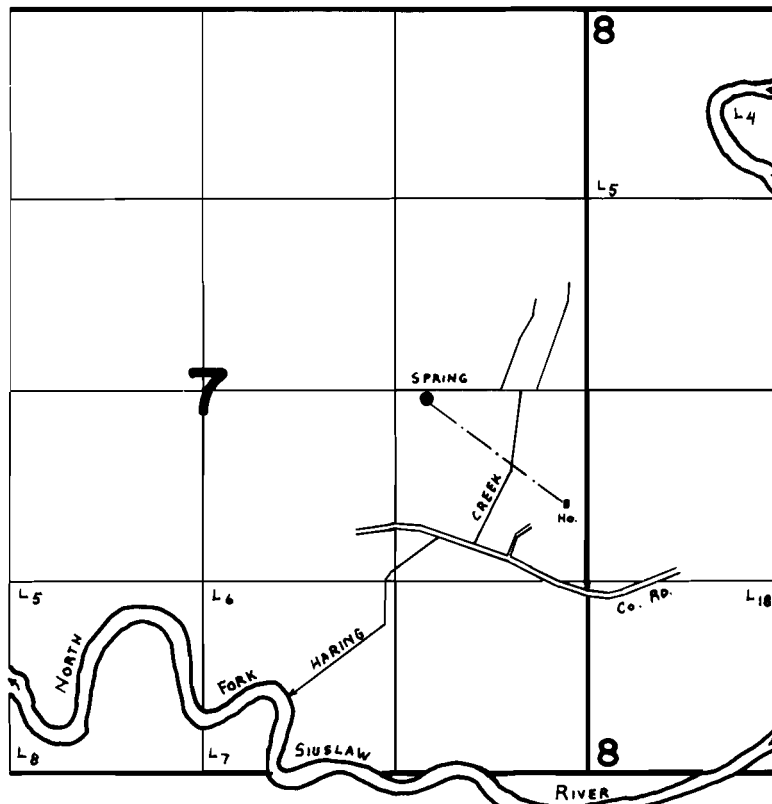

SPRING LOC: 70'S. & 1090'W. fr. E. 1/4 COR. SEC. 7.

FINAL PROOF SURVEY UNDER

Application No. 54104 Permit No. 40505
IN NAME OF

ROBERT H. & CYNTHIA L. HYLTON

Surveyed JULY 24 1978, by C. L. HUGHES