


T17S. R4W. WM.

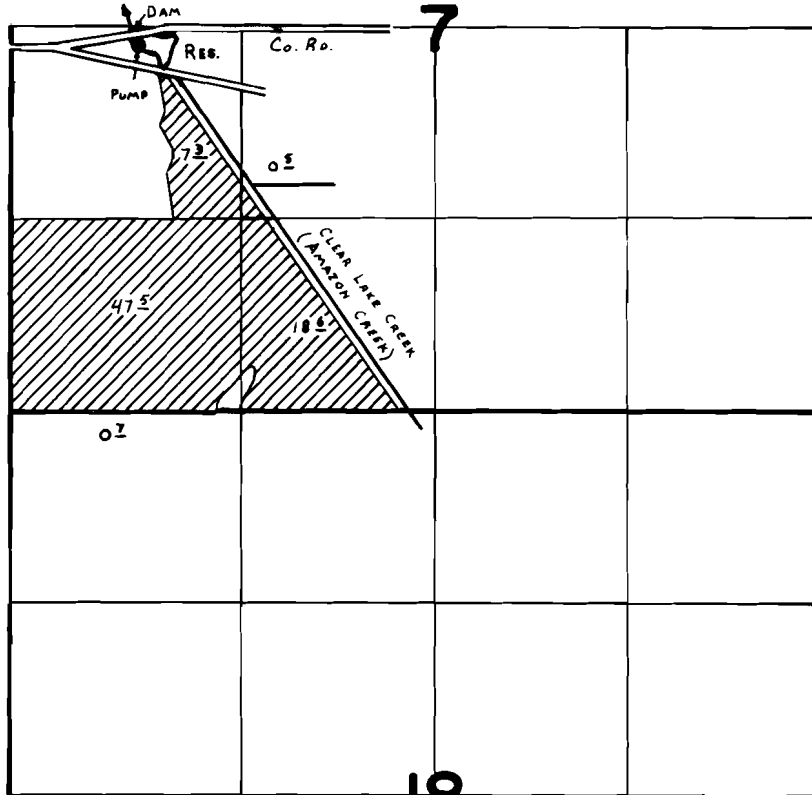

DAM Loc: 20'S. & 830'E. fr. W. 1/4 COR. SEC. 7.

FINAL PROOF SURVEY UNDER

Application No. 55595... Permit No. 41661...
IN NAME OF

BILL D. CHILDERS

Surveyed JUNE 12 1978, by C. L. HUGHES...