


# T16S. R2W. WM.

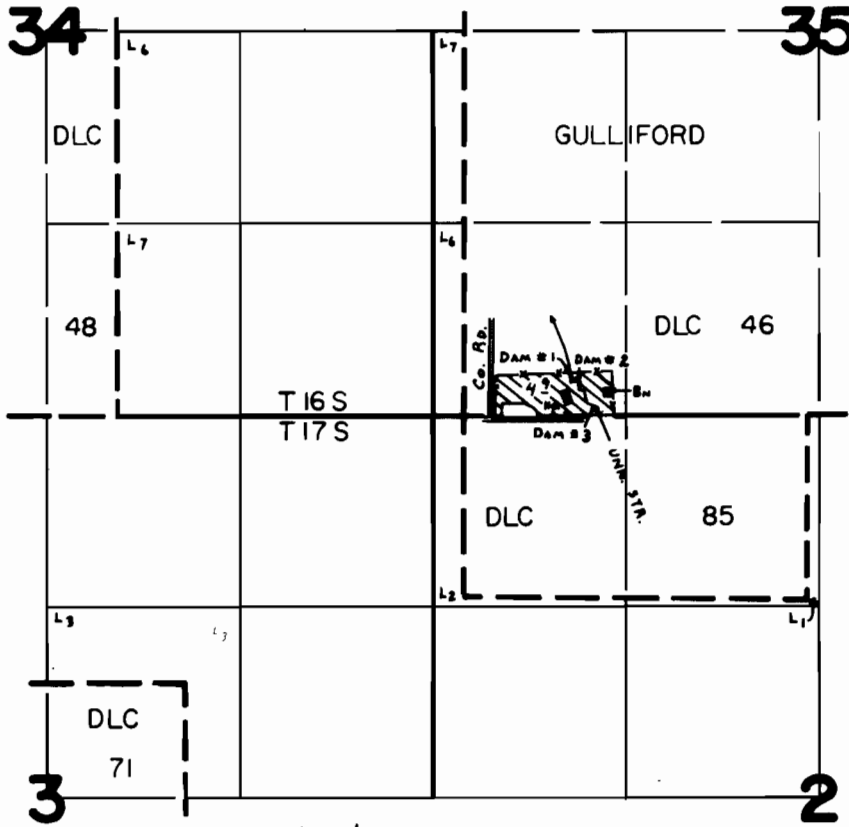

DAMS Loc: #1- 295' N. { 930' E. }  
 #2- 240' N. { 990' E. } ALL FROM S.W. COR. SEC. 35.  
 #3- 70' N. { 1100' E. }

## FINAL PROOF SURVEY UNDER

Application No. R-56904 56595 Permit No. R-6711 42406  
 IN NAME OF

PERCY O'DEAN LEAVITT

Surveyed JULY 17, 1978, by C. L. HUGHES