


T16S. R2W. WM.

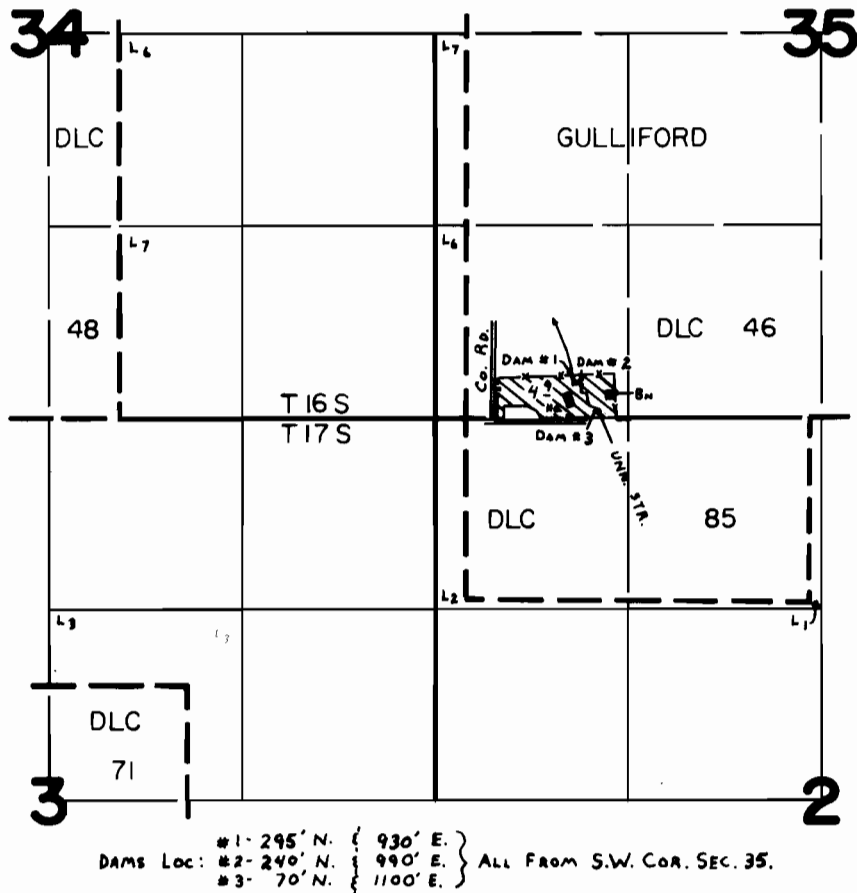

FINAL PROOF SURVEY
UNDER

Application No. 56595 R-56904 Permit No. 42406 R-6711
IN NAME OF

PERCY O'DEAN LEAVITT

Surveyed JULY 17 1978, by C. L. HUGHES