


T17S. R6W. WM.

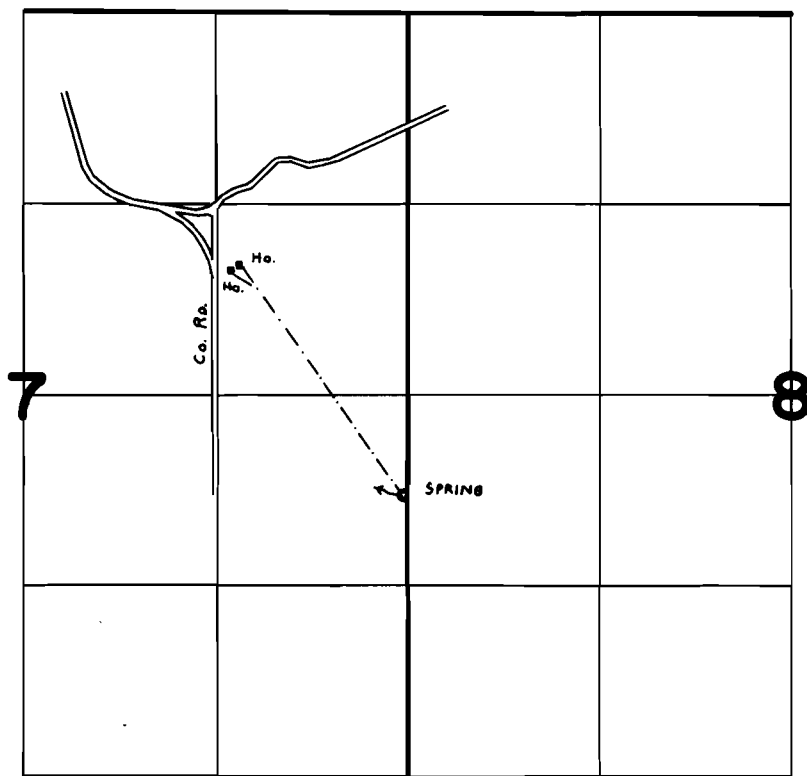

SPRING Loc: 1940' N & 30' W. fr. S.E. CoR. SEC. 7.

FINAL PROOF SURVEY
UNDER

Application No. 56516 Permit No. 42411
IN NAME OF

CECIL & EDITH GATEWOOD

Surveyed JUNE 13 1978, by C. L. HUGHES