T13S. R1 & 2E. WM.

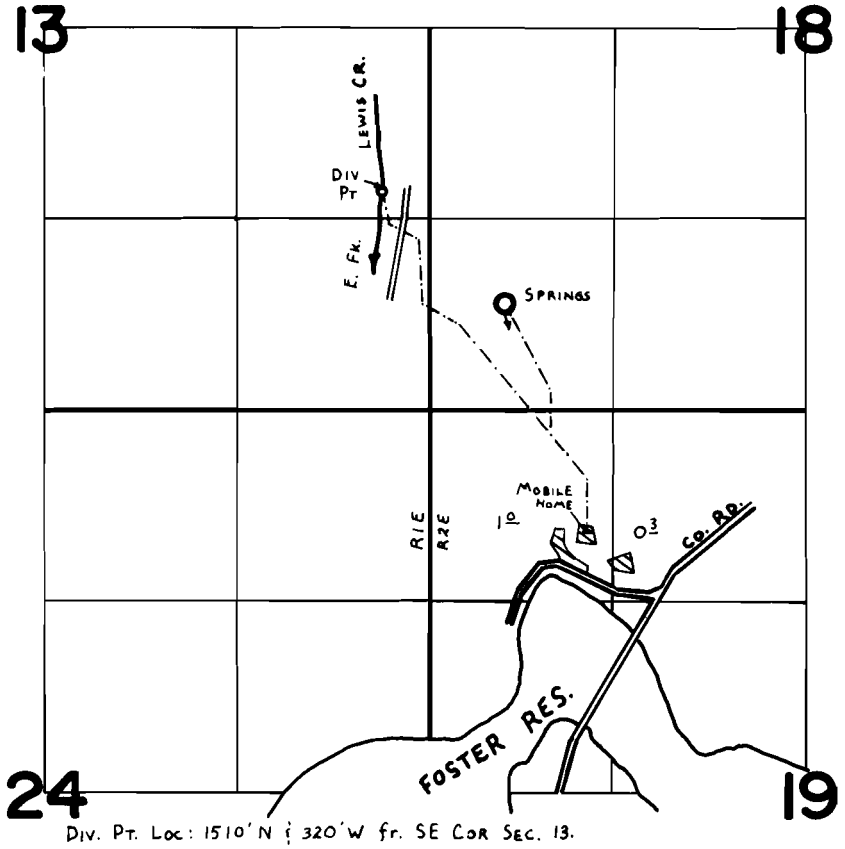

DIV. PT. LOC: 1510' N & 320' W fr. SE COR SEC. 13.
SPRINGS LOC: 730' N & 510' E. fr SW COR. SEC. 18.

FINAL PROOF SURVEY
UNDER

Application No. 54151 Permit No. 40540
IN NAME OF

MAXINE H. MARTIN

Surveyed MAY 3 1978, by C. L. HUGHES

PTS - 1978 - F
DFM - SLL - 33