


T5S. R9W. WM.

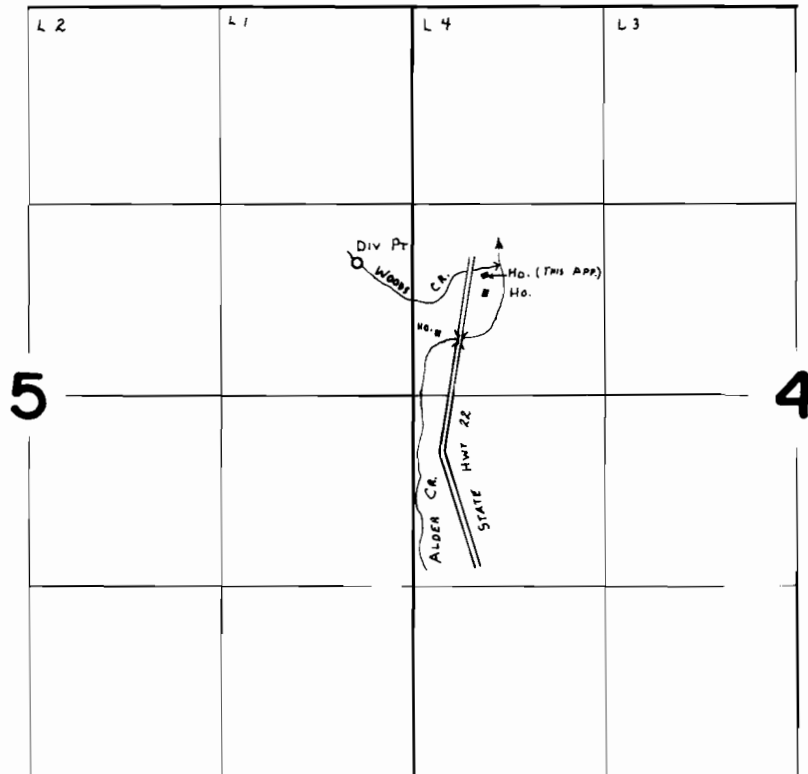

Div. Pt. Loc: 1750' S. & 380' W. fr. NE Cor. Sec. 5.

FINAL PROOF SURVEY UNDER

Application No. 51502 Permit No. 38870
IN NAME OF

LEWIS H. & ROSALIND K. COPLIN

Surveyed SEPT. 18 1978, by C. L. HUGHES