T1N. R4W. WM.

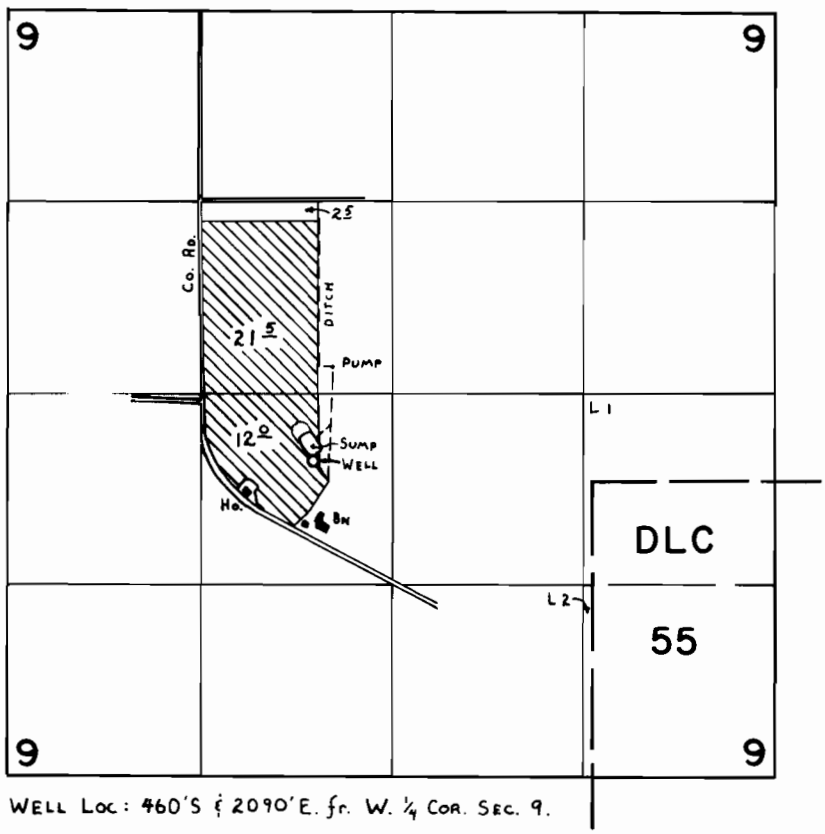

WELL LOC: 460'S & 2090'E. fr. W. ¼ COR. SEC. 9.

FINAL PROOF SURVEY
UNDER

Application No. G-7951 Permit No. G-7331
IN NAME OF

JOHN F. WOOD

Surveyed AUG. 10 1978, by C. L. HUGHES

DBS-2LL-98