


T1S. R5W. WM.

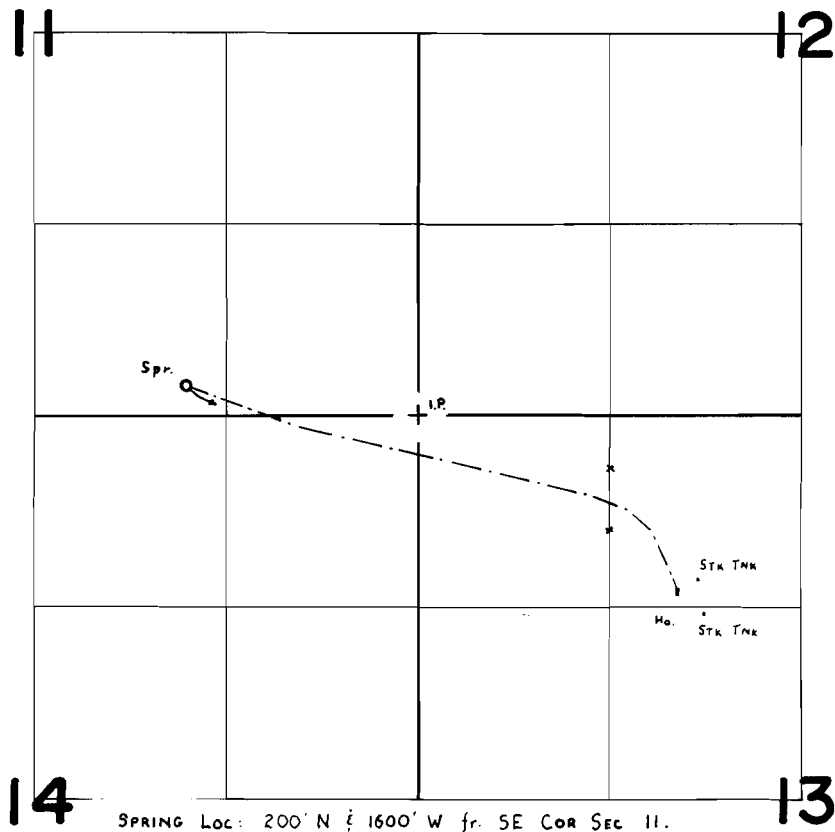

FINAL PROOF SURVEY
UNDER

Application No. 48174 Permit No. 36190
IN NAME OF

HENRY D. SCOTT

Surveyed AUG 11 1978, by C. L. HUGHES