


Application No. 56265
Permit No. 42513

T.2N. R.4W. W. M.

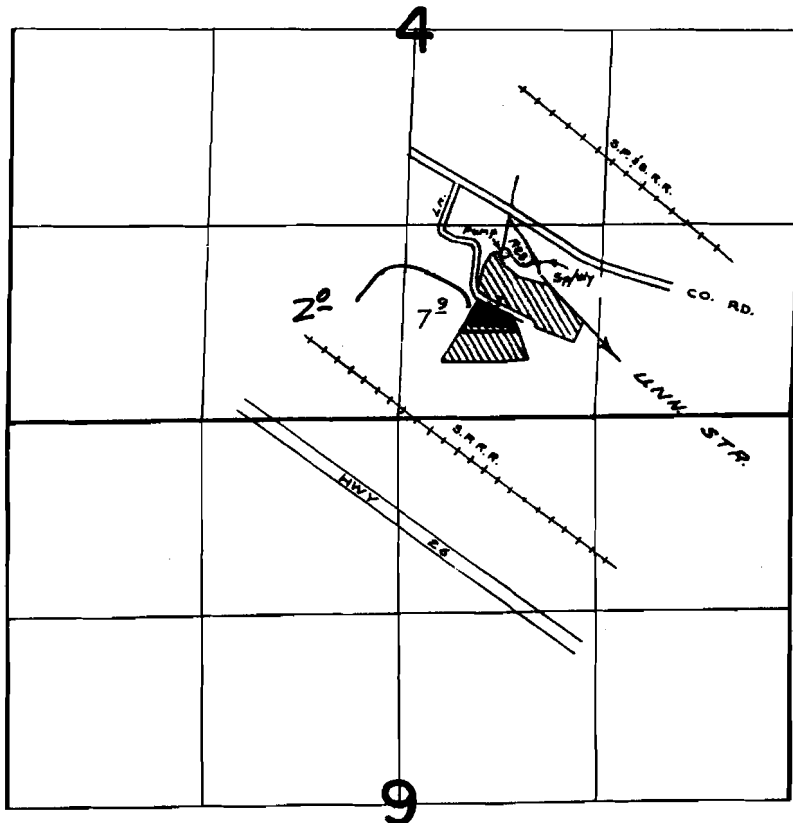

DAM LOCATED: 1130' N. and 710' E. from S. 1/4 CORNER SECTION 4

RECEIVED

DEC 20 1977

WATER RESOURCES DEPT.

FINAL PROOF SURVEY
UNDER

R-44497 R-5407
Application No. 44498 Permit No. 34067
IN NAME OF

LOYD MORGAN

Surveyed Sept. 12, 1975, by R. Mucken