


T. 5S. R. 3W. W.M.

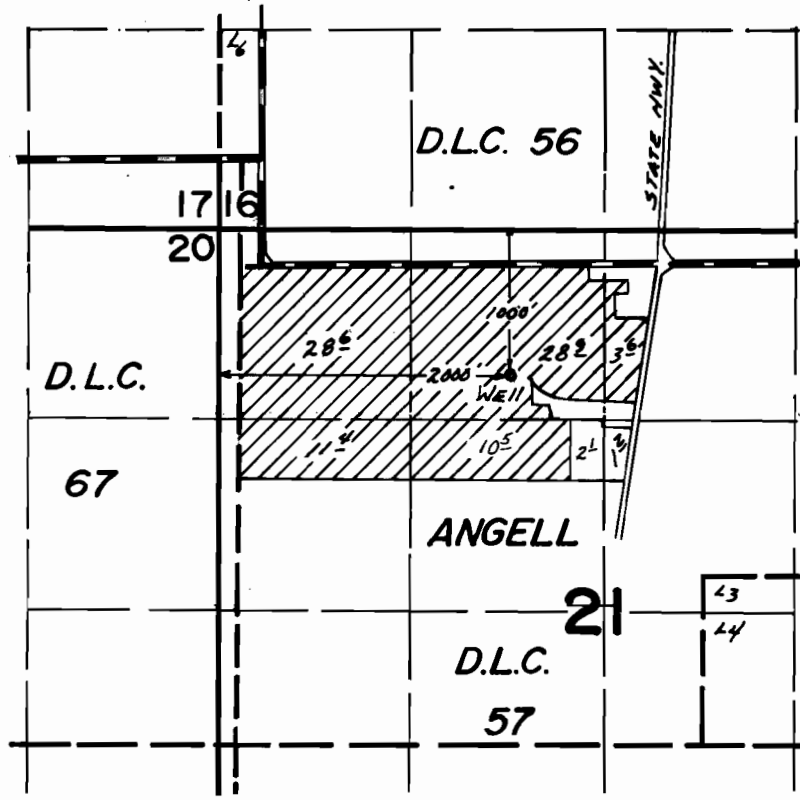

FINAL PROOF SURVEY UNDER

Application No. G-7134 Permit No. G-6585
IN NAME OF

..... LOUIE W. MAGEE

Surveyed March 6 1978, by L. H. Nunn.....