


T.5S. R.4W. W.M.

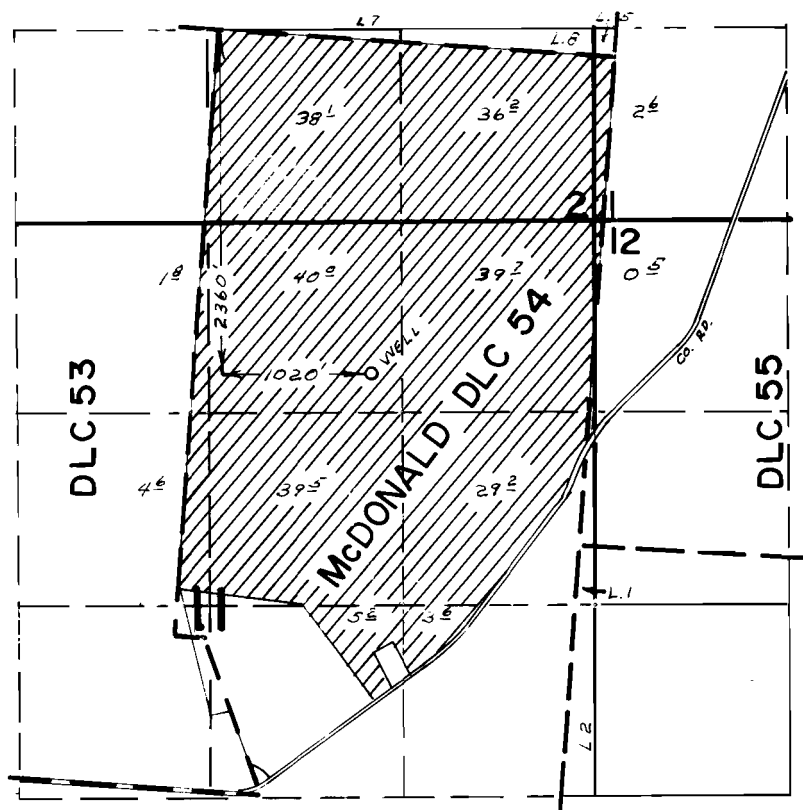

FINAL PROOF SURVEY UNDER

Application No G-7616... Permit No. G-7062..
IN NAME OF

JOSEPH, JERRY, JOE, & DENNIS D. DITCHEN

Surveyed MAR. 23, 1978., by L.H. NUNN.....