


# T. 5S.R. 4W. W.M.

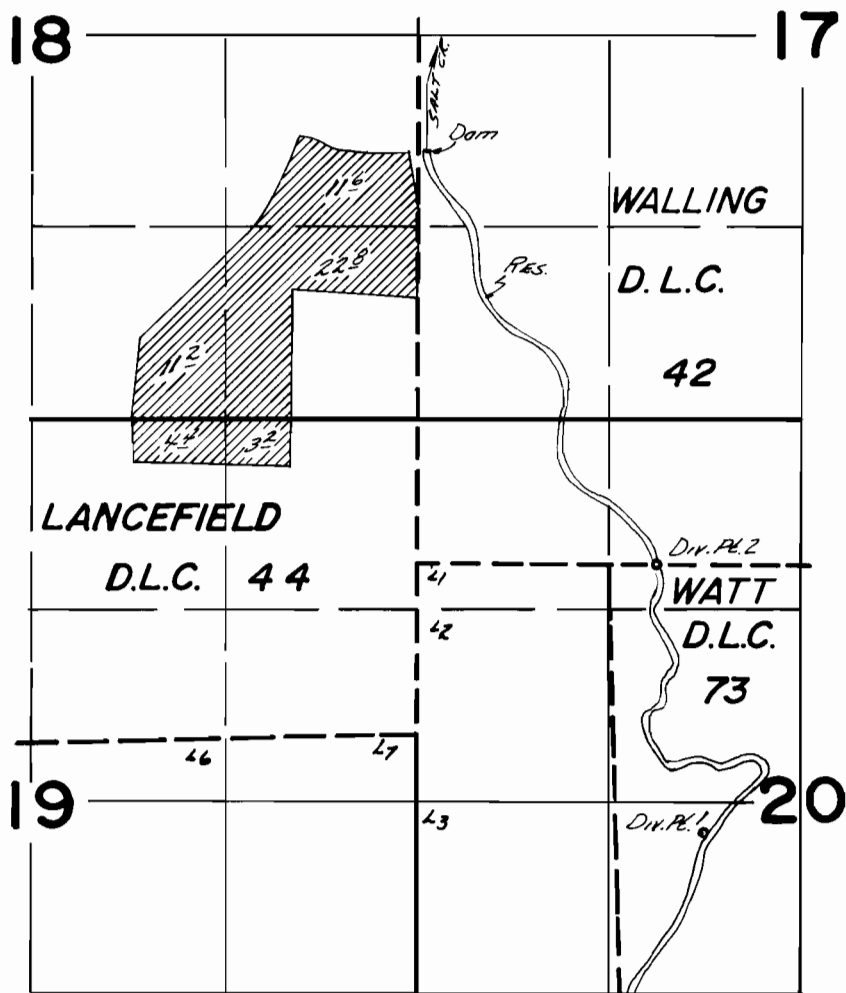

*Div. Pl. Loc: 670.5' 1980'E, 1180' N 1650'E., Dam 4020' N 70'E  
All from SE Cor. Lancefield D.L.C. 44*

## FINAL PROOF SURVEY UNDER

Application No. 50890... Permit No. 37762...  
IN NAME OF

LANCEFIELD FARM CO.....

Surveyed March 14 1978., by L.H.Nunn.....