


T.5S.R.6W. W.M.

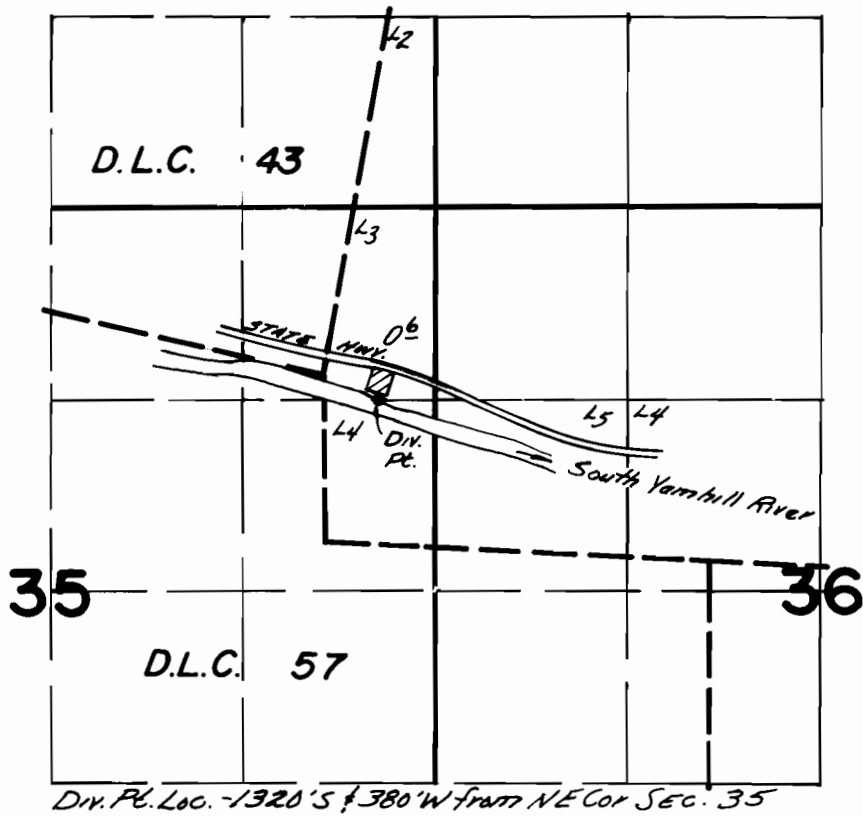

FINAL PROOF SURVEY UNDER

Application No. 52341... Permit No. 39364...
IN NAME OF

RAYMOND MISHLER

Surveyed March 17, 1978., by L.H.Nunn