T5S. R6W. WM.

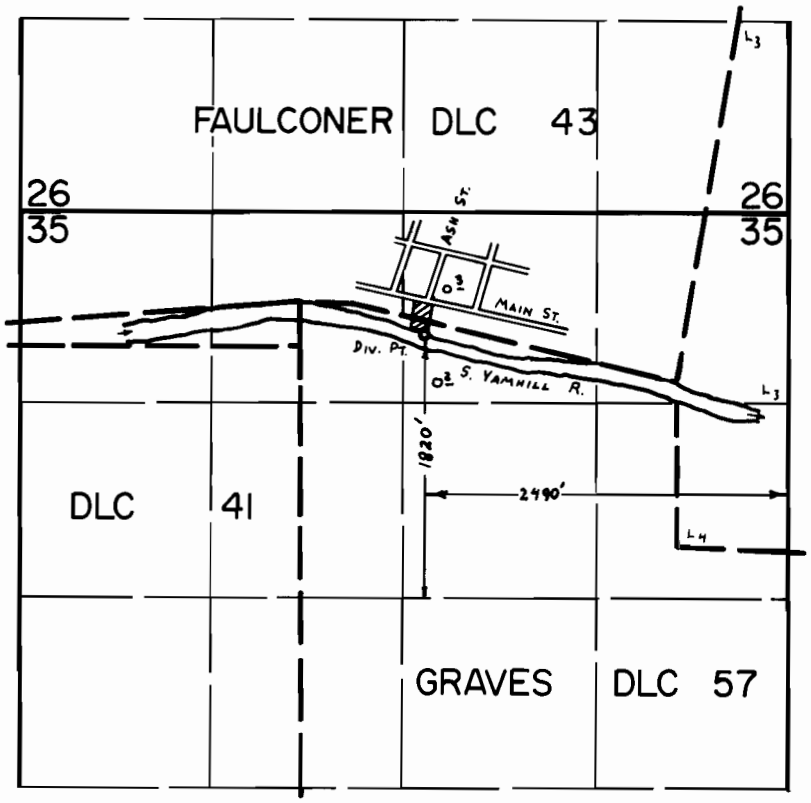

FINAL PROOF SURVEY
UNDER

Application No. 53018 Permit No. 40016
IN NAME OF

RAYMOND MISHLER

Surveyed SEPT 8 1976, by L. H. NUNN

DFQ-3LL-149