


T. 5S. R. 6W. W.M.

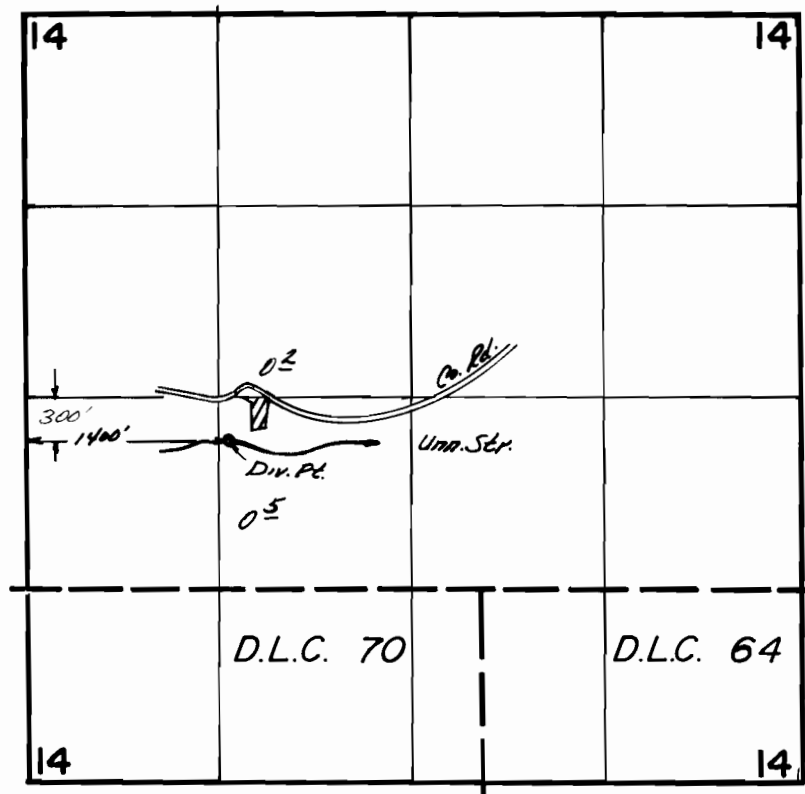

**FINAL PROOF SURVEY**  
UNDER

Application No. 52569 Permit No. 39657...  
IN NAME OF

ROBERT D. LIEGH

Surveyed March 17 1978, by L. H. Nunn