T5S. R6W. WM.

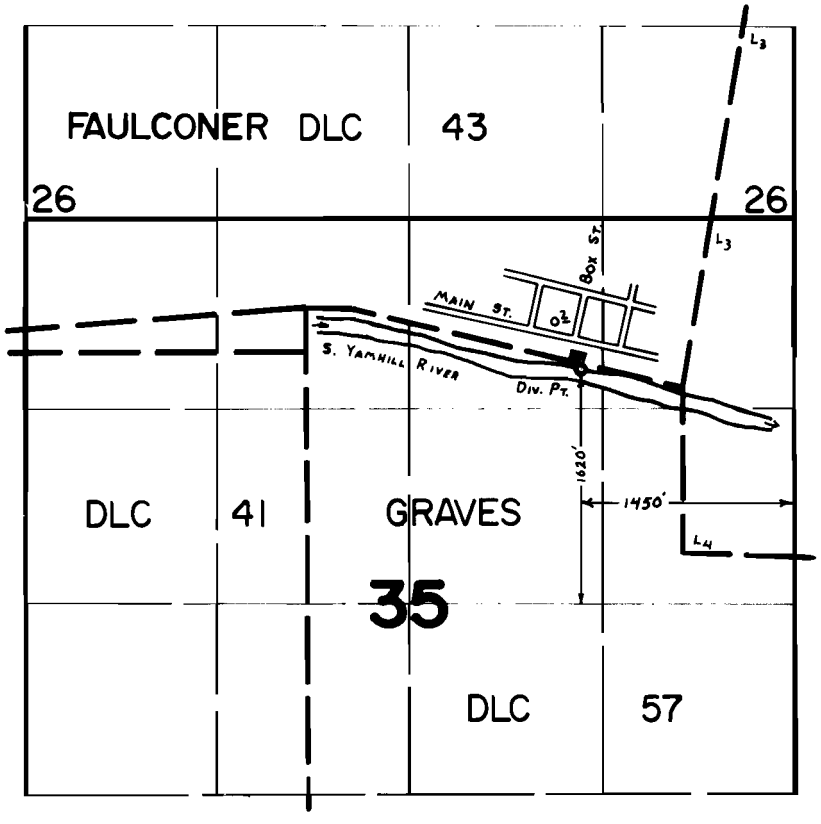

FINAL PROOF SURVEY
UNDER

Application No. 52996 Permit No. 40003
IN NAME OF

JOHN & HELEN BUCKLES

Surveyed SEPT 8 1976, by L. H. NUNN

DFQ-3LL-149