


T. 5S. R. 6W. W.M.

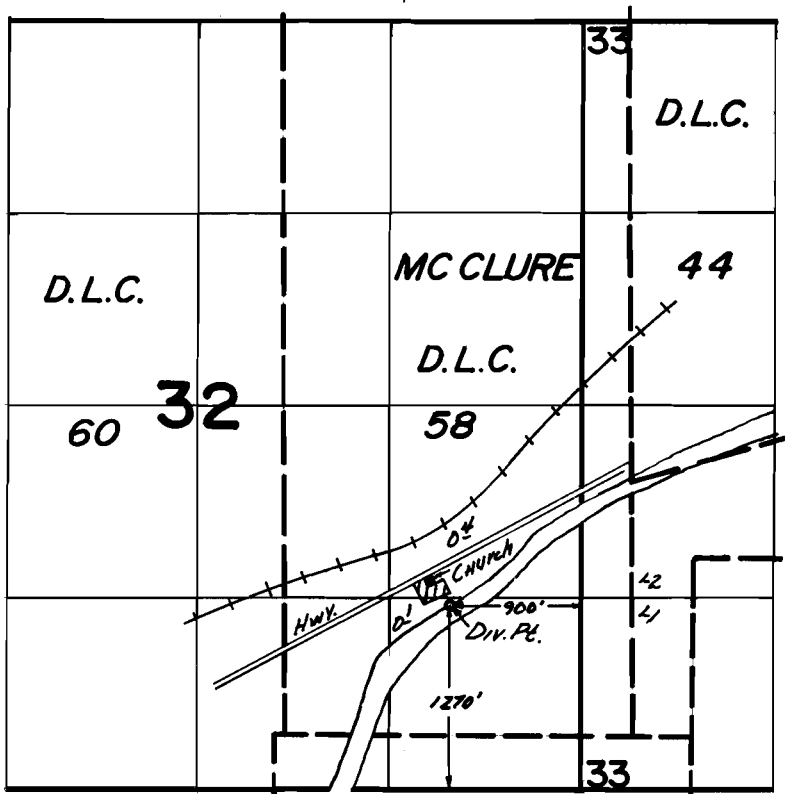

FINAL PROOF SURVEY UNDER

Application No. 53022.. Permit No. 4.0312...

IN NAME OF

Sheridan Congregation of
Jehovah's Witnesses.....

Surveyed May...5... 1978., by L.H.Nunn.....