


# T. 5S. R. 6W. W.M.

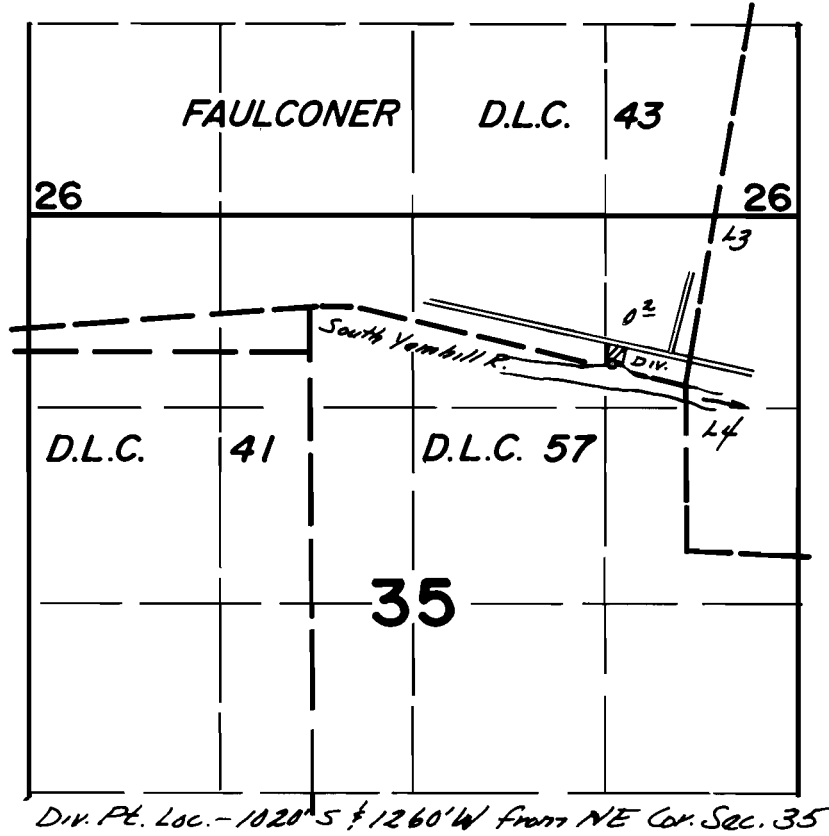

## FINAL PROOF SURVEY UNDER

Application No. 54441... Permit No. 40825...  
IN NAME OF

PAUL & EDNA R. REMILLAND...

Surveyed May 5, 1978, by L.H. Nunn.....