


# T2S R3W WM

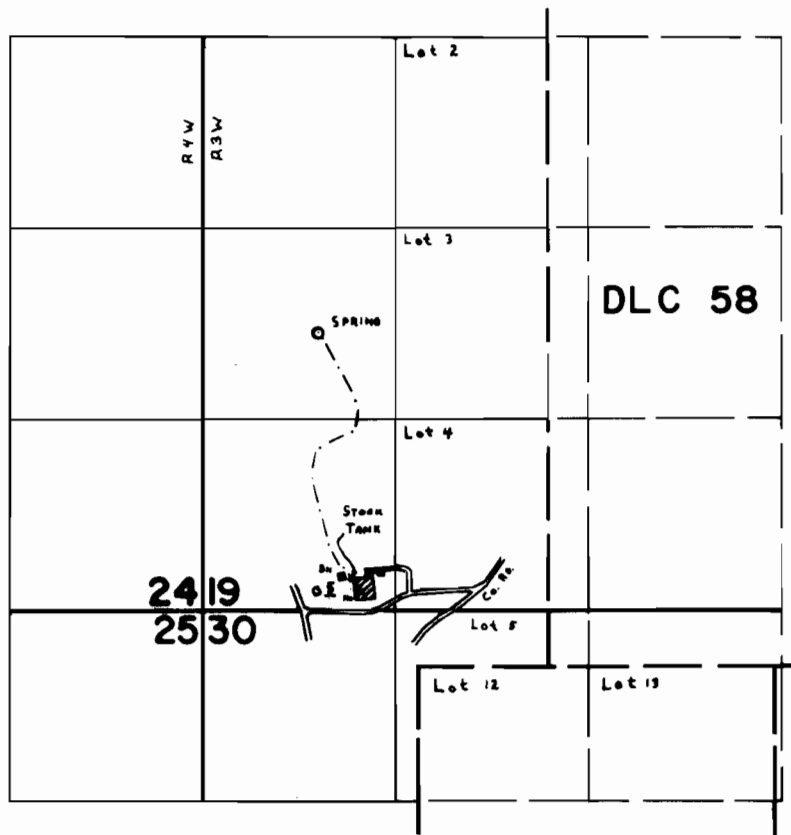

SPRING Loc: 1910' N & 780' E fr. SW Cor SEC 19.

## FINAL PROOF SURVEY UNDER

Application No. 56197 Permit No. 42110

IN NAME OF

LEO F. STICKA

Surveyed OCT 19 1978, by C L HUGHES