


T.5S. R.1E.&1W.W.M.

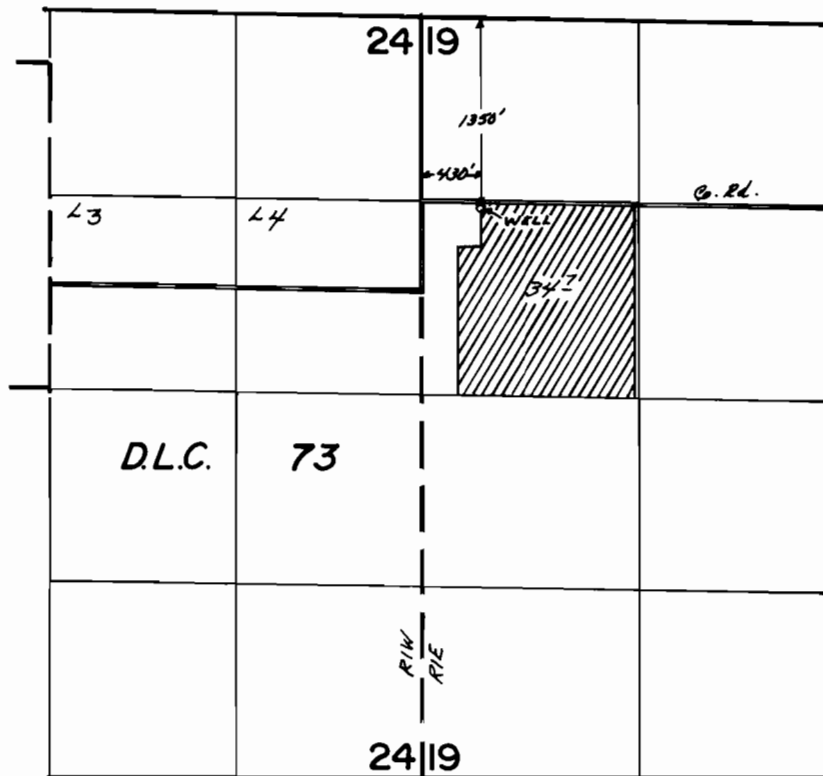

FINAL PROOF SURVEY UNDER

Application No. G-6895. Permit No. G-6424.
IN NAME OF

.....LEO & CAROL ANN ILG.....

Surveyed MAY...1... 1978., by J.S.Donaldson....