


T. 4S. R. 1E. W.M.

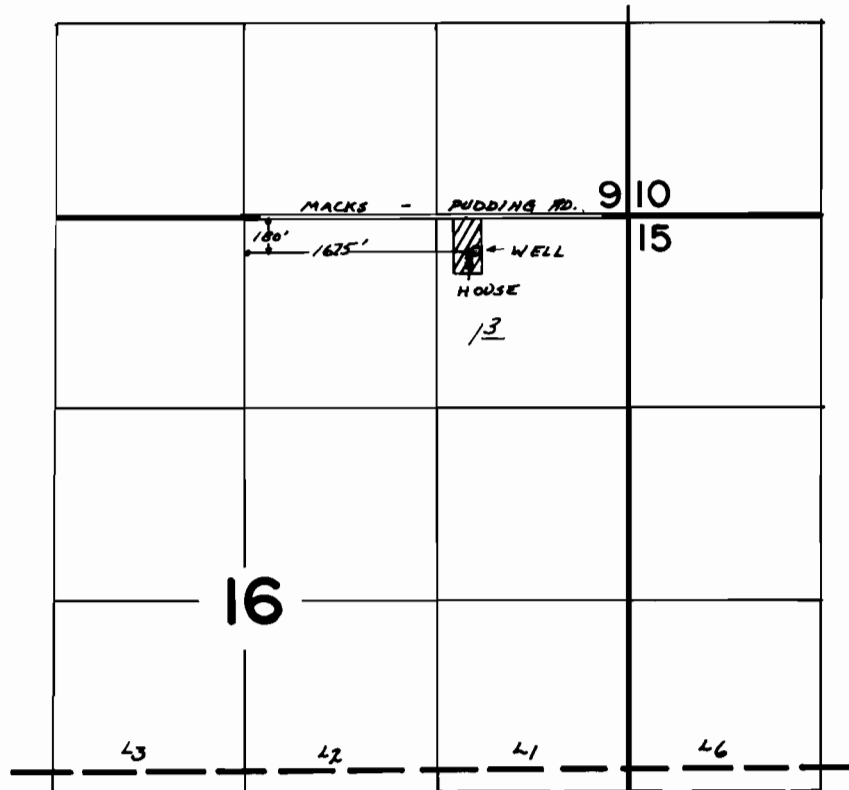

FINAL PROOF SURVEY
UNDER

Application No. G-7811 Permit No. G-7379
IN NAME OF

JOHN P. & JANET H. HILL

Surveyed MAY 4, 1978, by J.S. Donaldson