


T.40S. R.14W. W.M.

Sec. 25

NW 1/4

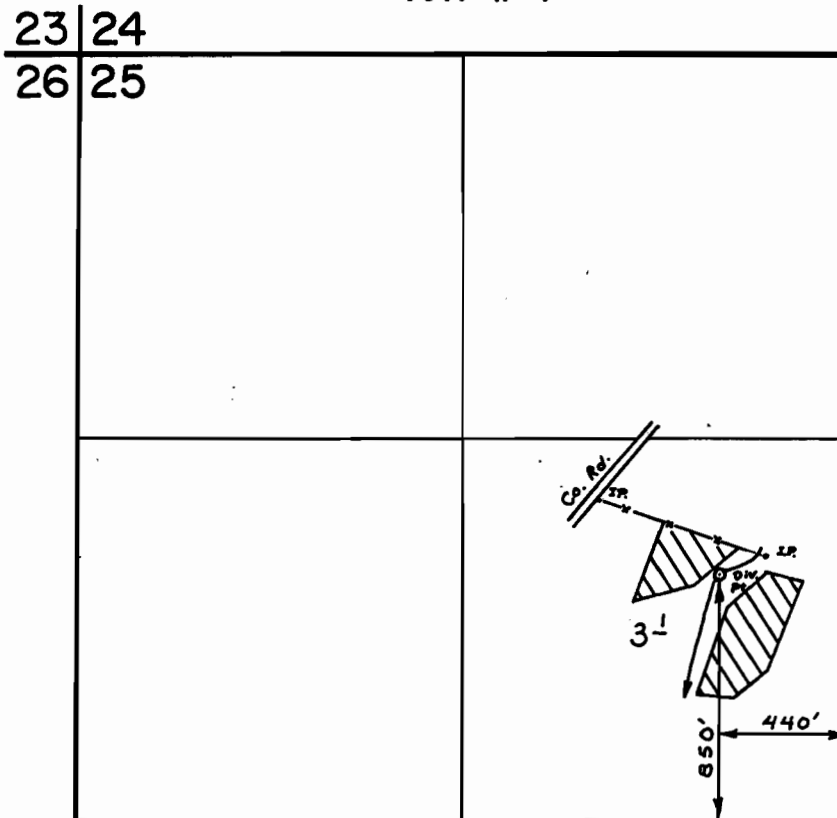

SCALE : 1" = 660'

FINAL PROOF SURVEY
UNDER

Application No. 48793 Permit No. 36578
IN NAME OF

A. WILLIAM & ROSE MARIE McWATTERS

Surveyed Dec. 1 1977, by D. Sparks