


T. 27 S., R. 6 W., W. M.

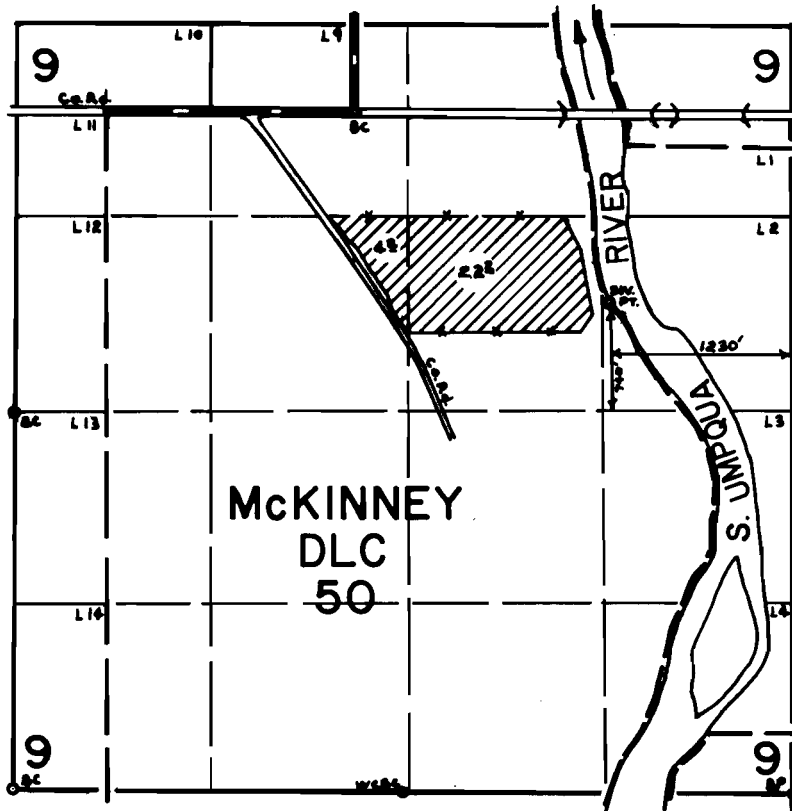

FINAL PROOF SURVEY
UNDER

Application No. 53068 Permit No. 38566
IN NAME OF

STEPHAN BLAKE CONN

Surveyed DEC. 8 1977, by D. W. SPARKS.