


T.21S. R.5W. W.M.

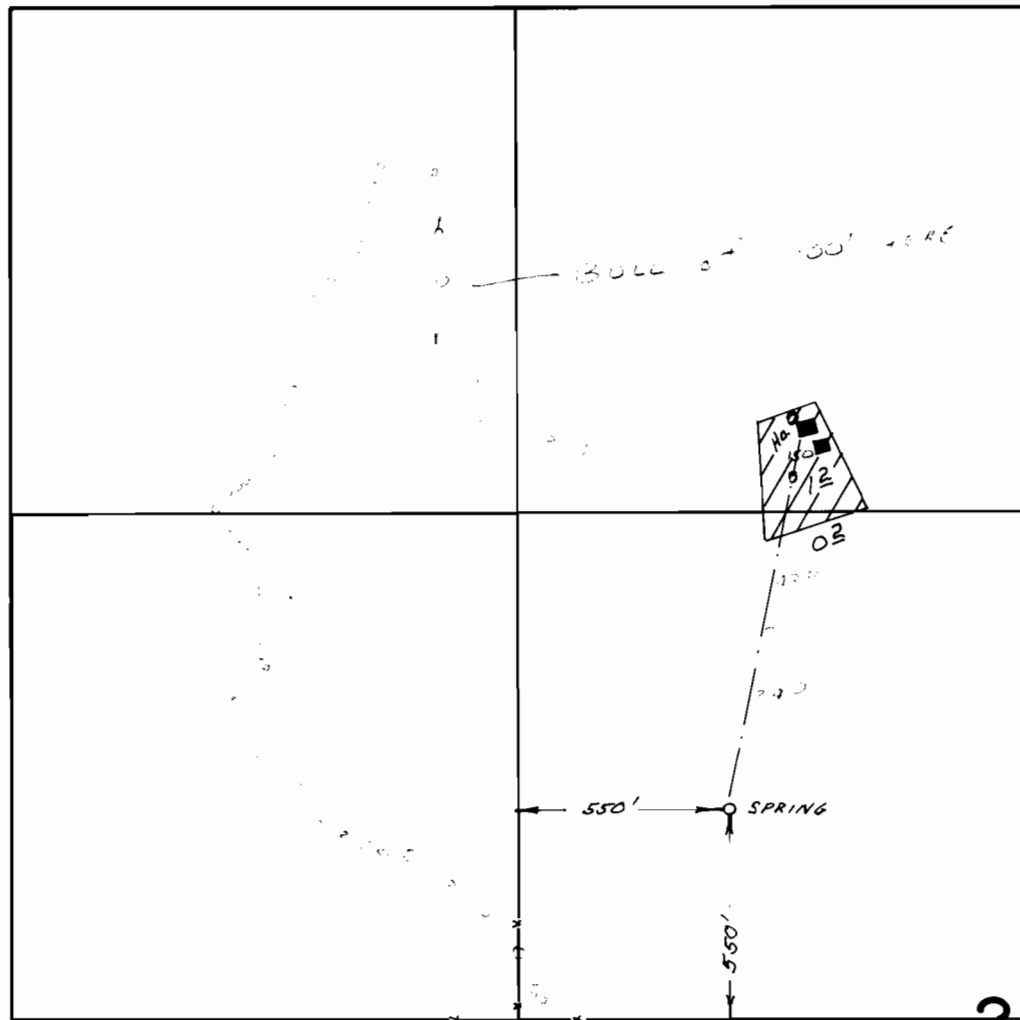

DRAFTED
WRONG
100' BULL
IN PROPOSED
TURN FOUND

SCALE 1" = 500'


FINAL PROOF SURVEY
UNDER

Application No. 52721... Permit No. 39832...
IN NAME OF

JOHN M. & HELEN R. RENTZ...

Surveyed APR. 19. 1977, by L.H. NUNN...

T.21S. R.5W. W.M.

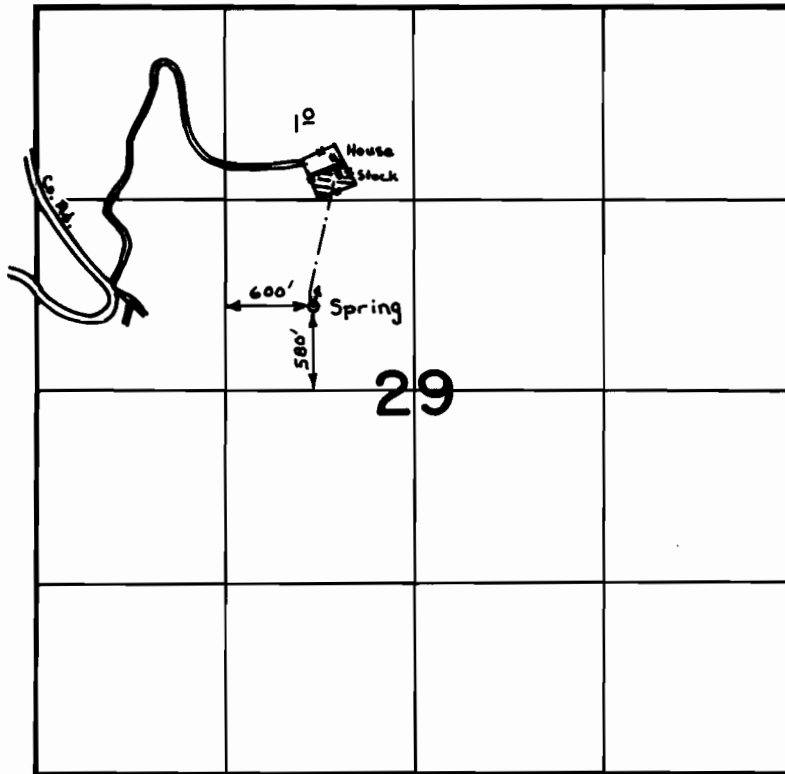

SCALE: 4" = 1 mile

FINAL PROOF SURVEY
UNDER

Application No. 52721 Permit No. 39832
IN NAME OF

JOHN M. & HELEN R. RENTZ

Surveyed Oct. 1 1979, by S. Donaldson.