


T. 30S., R. 5W., W.M.
SEC. 31

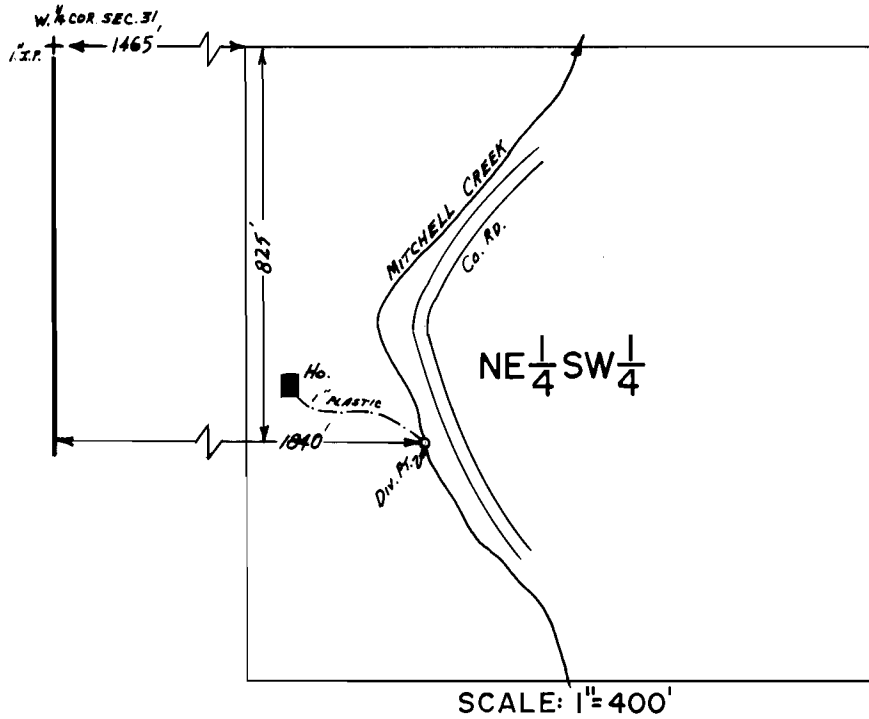

FINAL PROOF SURVEY
UNDER

Application No. 56824. Permit No. 42671.....
IN NAME OF

.....IRA A. & LURA D. SUTTON.....

Surveyed JULY 6... 1978, by D. HENRY.....