


T9S. R27E. WM.

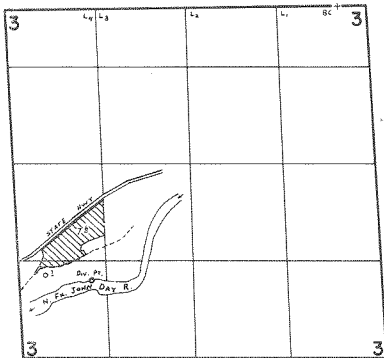

Div. Pt. Loc: 1060' N. E 930' E. fr. S.W. Cor. Sec. 3.

FINAL PROOF SURVEY UNDER

Application No. 53503 Permit No. 40049
IN NAME OF

DON CAPON

Surveyed Oct. 18 1977, by S. C. BROWN