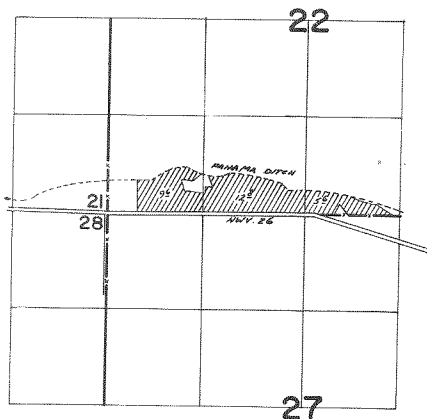
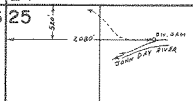


41844

50090

T.13S.R.30E.W.M.

23|24
26|25

DIV. PT. FOR PANAMA DITCH

FINAL PROOF SURVEY
UNDERApplication No. 55521 Permit No. 41844
IN NAME OF

DON MCKROLA

Surveyed June 9 1978, by J.S.Donaldson