


# T. 35 S., R. 3 W., W.M.

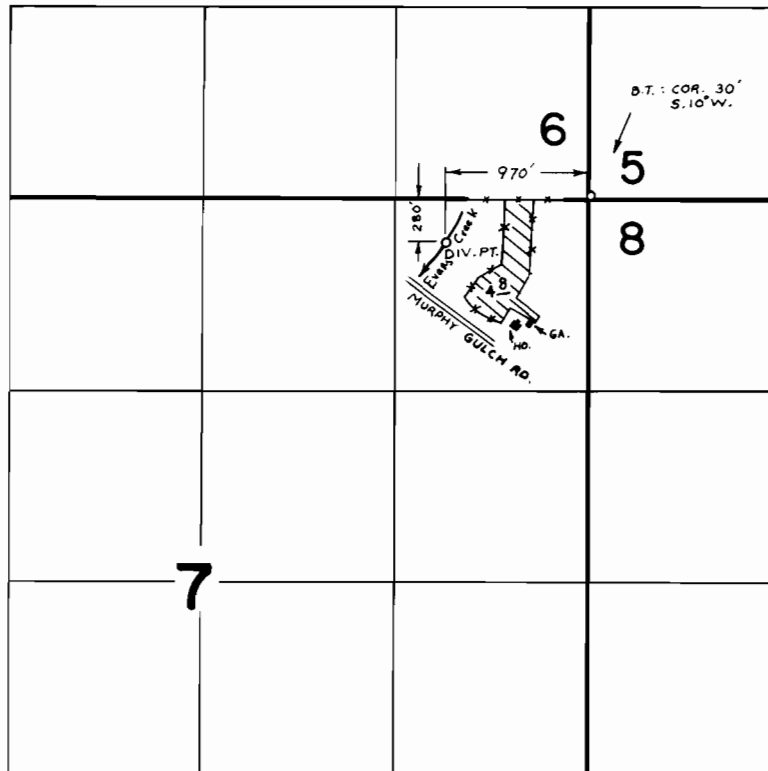

## FINAL PROOF SURVEY UNDER

Application No. 50100 Permit No. 37644  
IN NAME OF

Marcel & Paulena C. Verzeano

Surveyed MAY 18 1978, by B. SUND